T.13S., R.6W., W.M.

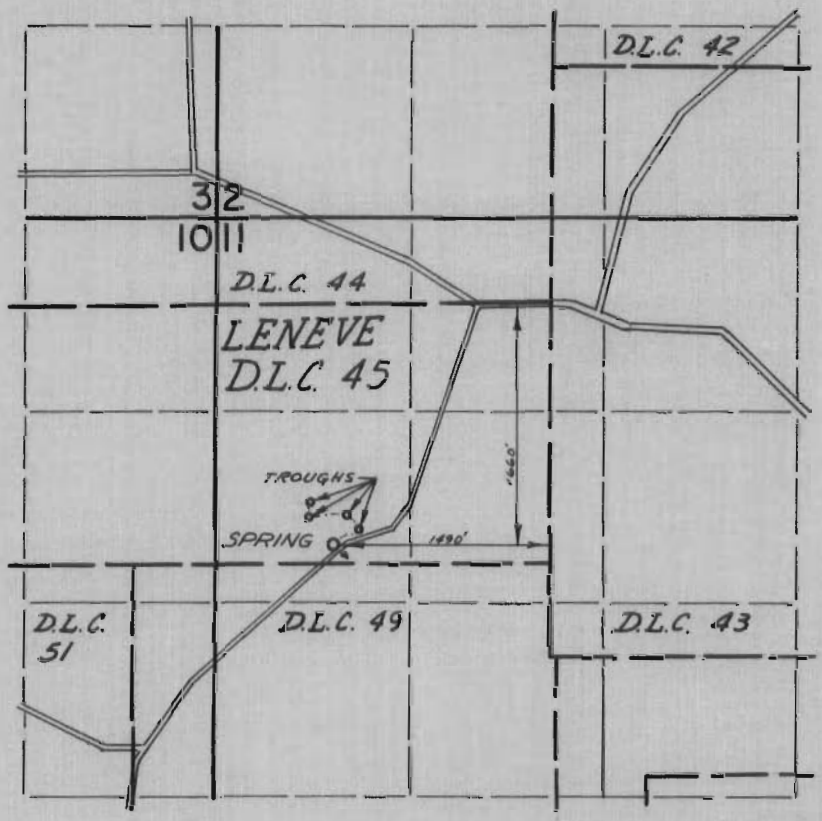

FINAL PROOF SURVEY
UNDER

Application No. 47687 Permit No. 35677
IN NAME OF

JOSEPH H. BEELART

Surveyed APRIL 2 19 73, by D. NORBY

DFJ-ALL-16