


T.13S., R. 6W., W.M.

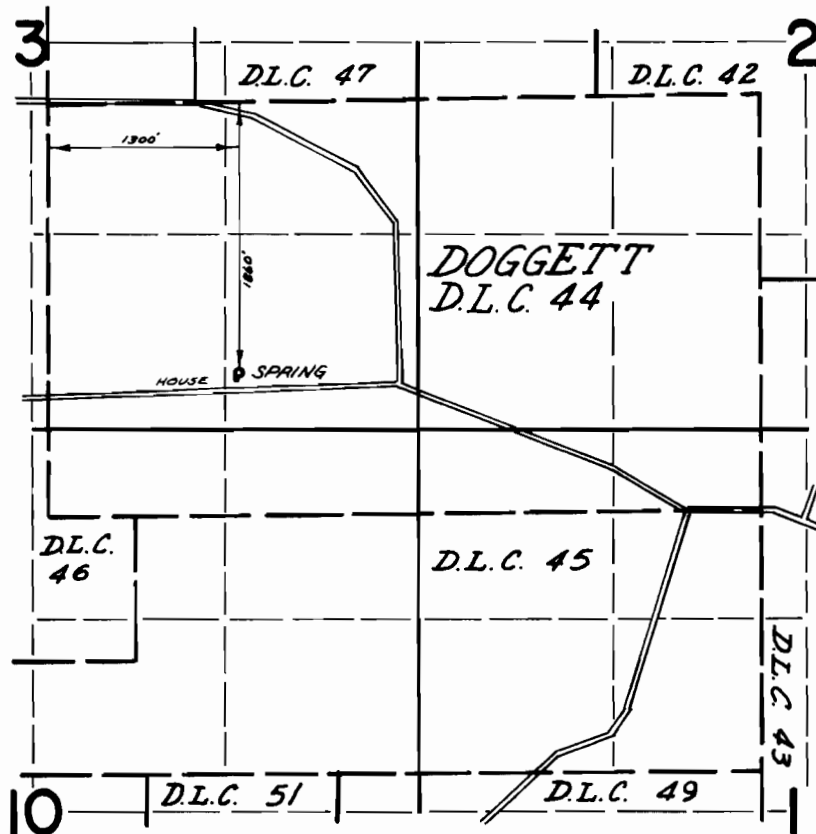

FINAL PROOF SURVEY
UNDER

Application No. 47890 Permit No. 35885
IN NAME OF

GEORGE R. & LEONA V. DROST

Surveyed APRIL 3 1973, by D. NORBY