


T. 10 S., R. 6 W., W. M.

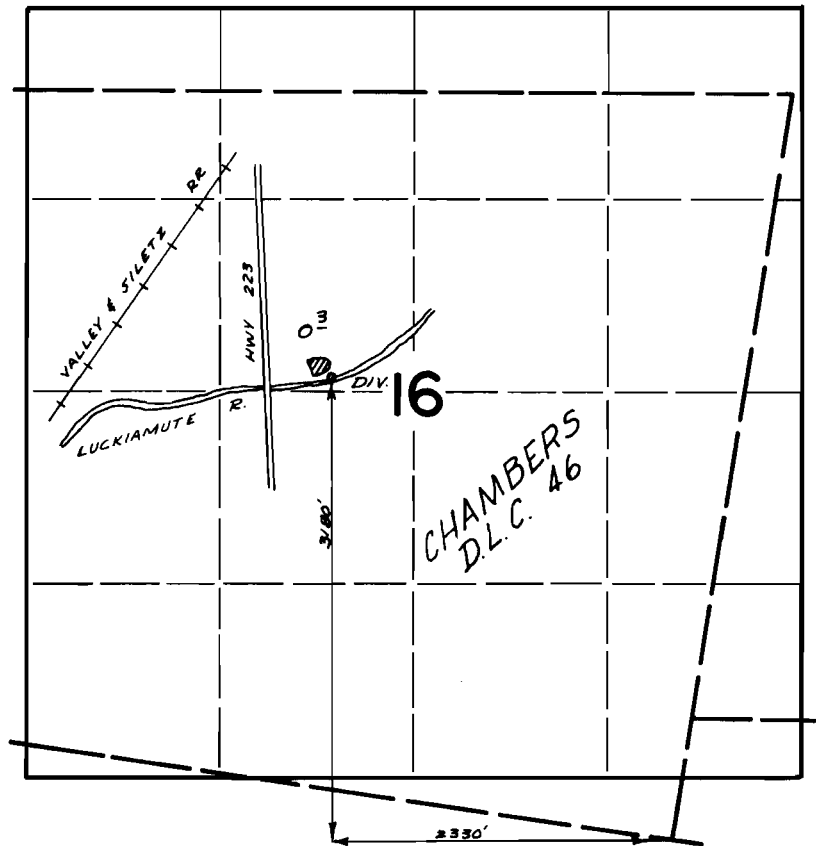

FINAL PROOF SURVEY
UNDER

Application No. 47938 Permit No. 35944
IN NAME OF

JOHN C. CRUMLEY

Surveyed MAR 21 1973, by D. NORBY