


T.13S., R.4&5W., W.M.

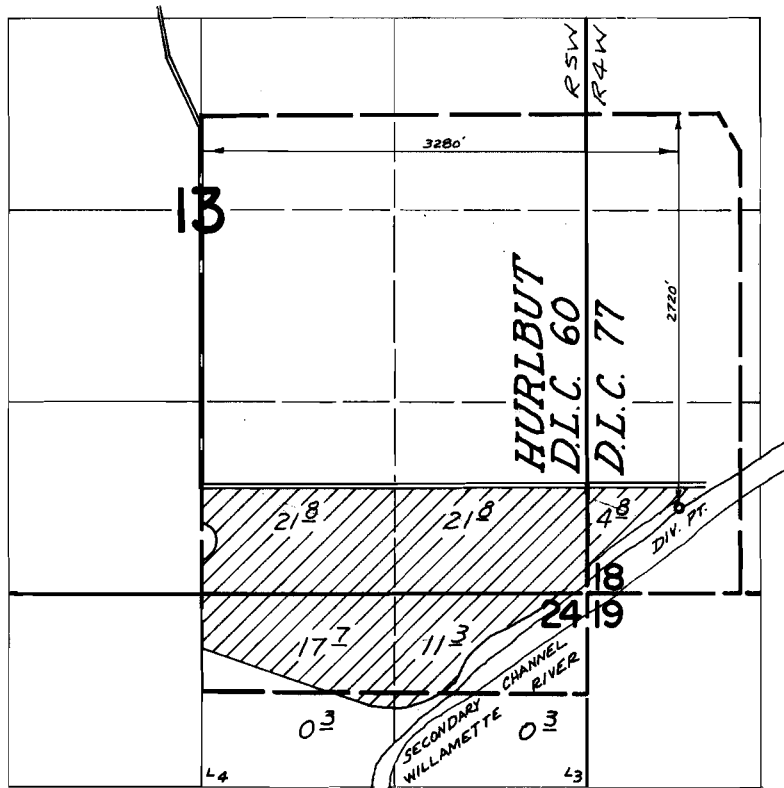

FINAL PROOF SURVEY
UNDER

Application No. 48519 Permit No. 36403
IN NAME OF

CLARENCE VENELL

Surveyed June 8 1973, by D. Norby