


T.11S., R. 6W., W.M.

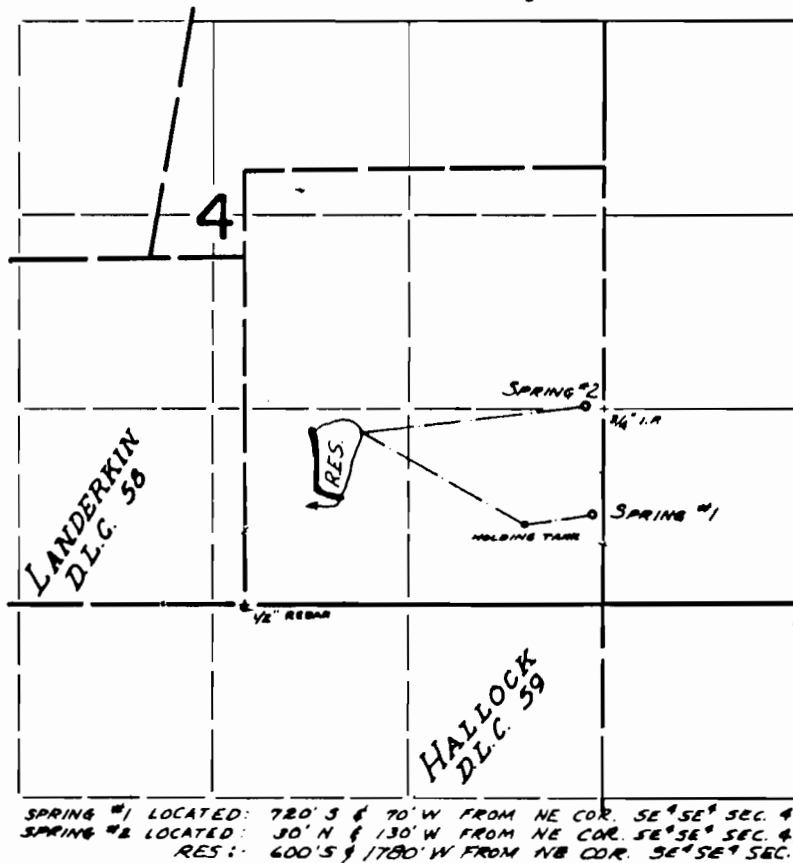

FINAL PROOF SURVEY
UNDER

R-45682 R-5418
Application No. 45683 Permit No. 34115
IN NAME OF

PIOTR ZENCZAK

Surveyed August 23 1973, by D. Norby