


T. 10 S., R. 6 S., W.M.

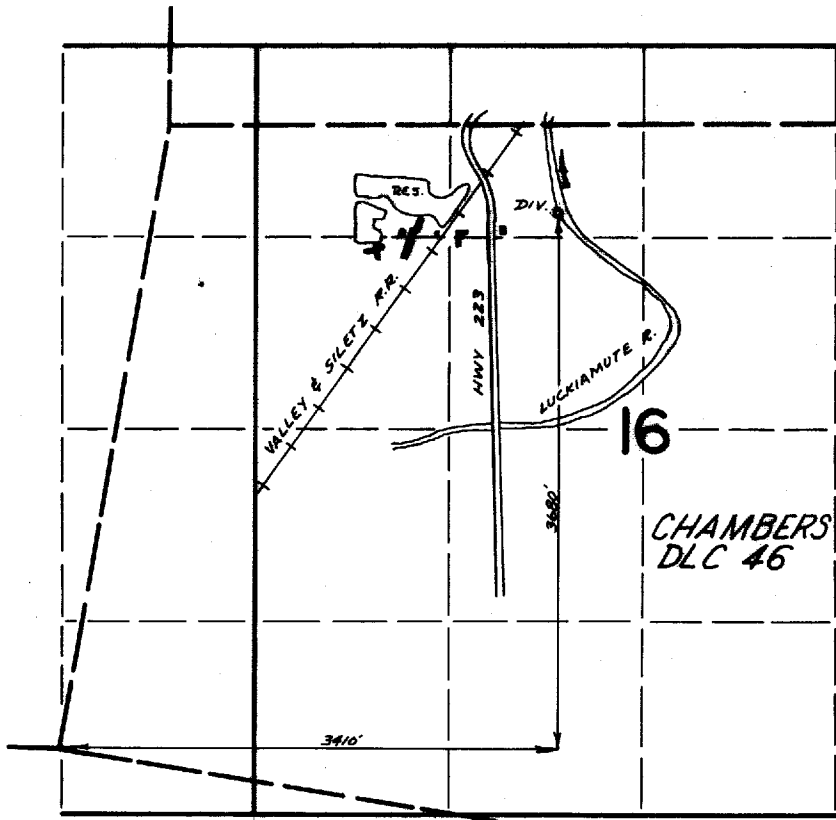

FINAL PROOF SURVEY
UNDER

Application No. 47167 R. 47521 Permit No. 35346 R. 5683
IN NAME OF

MOSEY LUMBER COMPANY

Surveyed MAR 21 1973, by D. NORBY