


T. 3 S. R. 1 W. W. M.

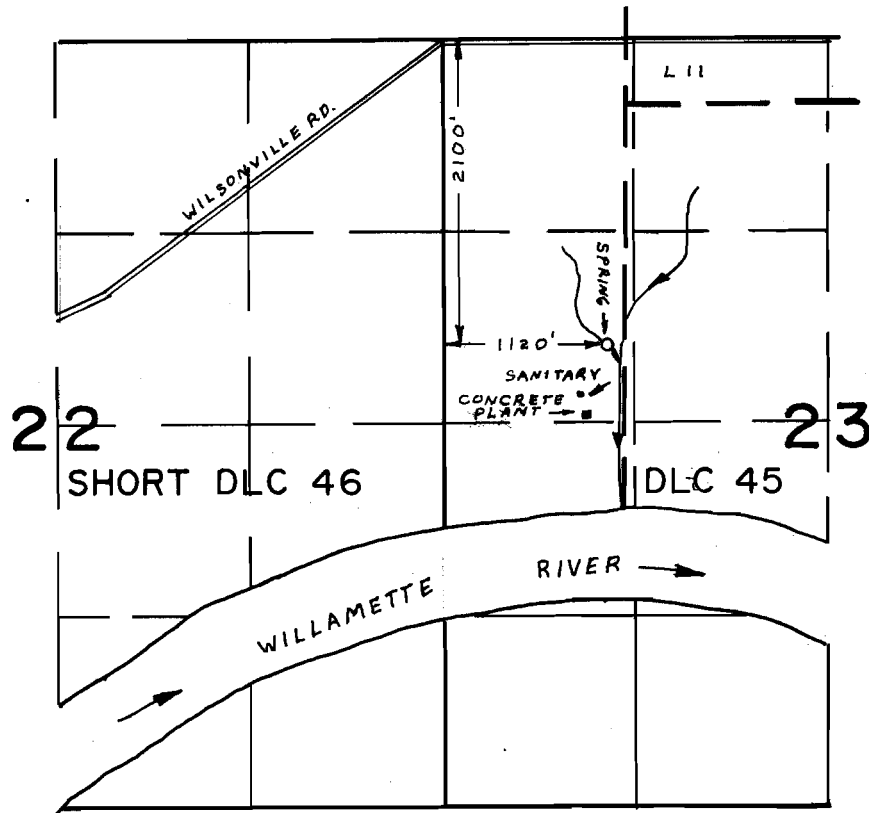

FINAL PROOF SURVEY UNDER

Application No. 38627 Permit No. 29885
IN NAME OF

Joe Bernert Towing Co. Inc.

Surveyed AUG. 16 1974 by L. H. NUNN