


T.4S. R.3E. W.M.

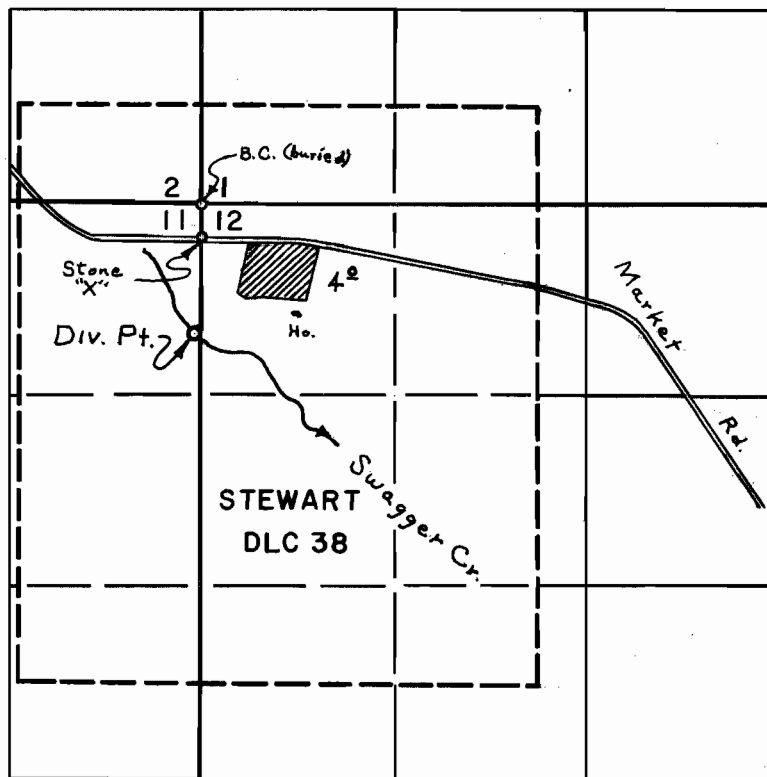

Div. Pt. Loc: 890' S. 40' W. From N.E. cor. Sec. 11

FINAL PROOF SURVEY
UNDER

Application No. 41144 Permit No. 30673
IN NAME OF

MICHAEL W. & CAROLINE BURKE

Surveyed Oct. 3, 1973 by R. Mucken