


T.2S. R.6E. W.M.

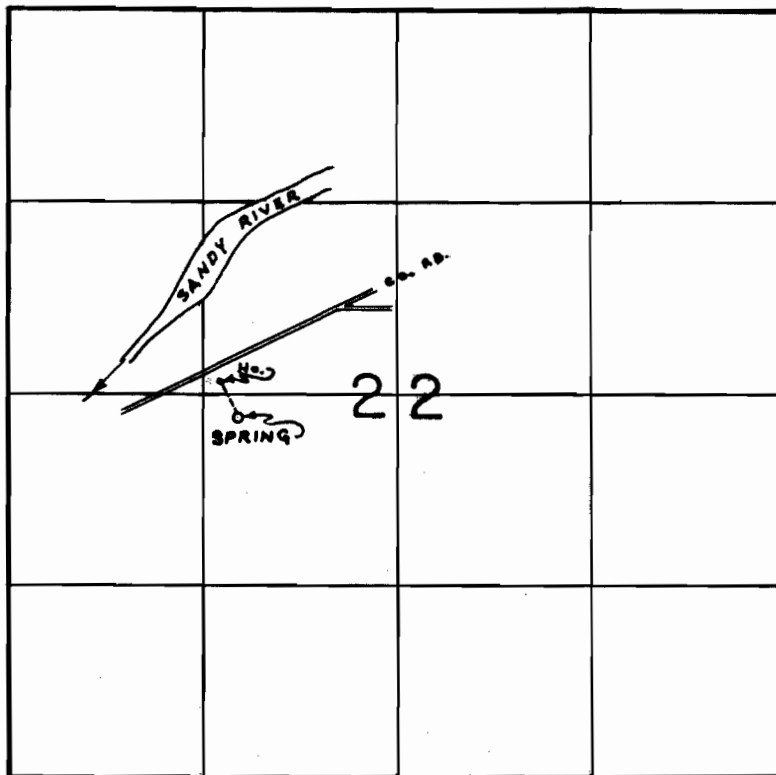

SPRING LOC: 150' S. 1100' W. FROM CEN. SEC. 22

FINAL PROOF SURVEY
UNDER

Application No. 43506 Permit No. 32542
IN NAME OF

Cecil R. White

Surveyed SEPT. 14, 1973, by R. MUCKEN