


T.30S. R.6W. WM.

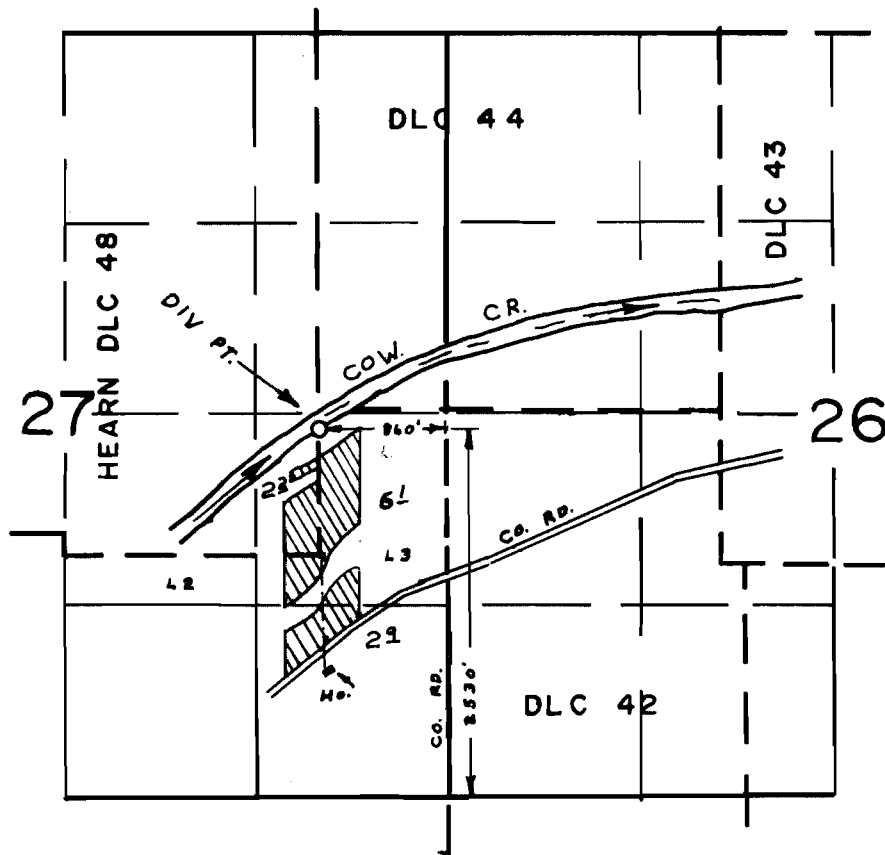

FINAL PROOF SURVEY
UNDER

Application No. 41943 Permit No. 31465
IN NAME OF

BRUCE CUNLIFF

Surveyed JULY 10 1974, by L.H. NUNN