


T.30S.R.2W.W.M.

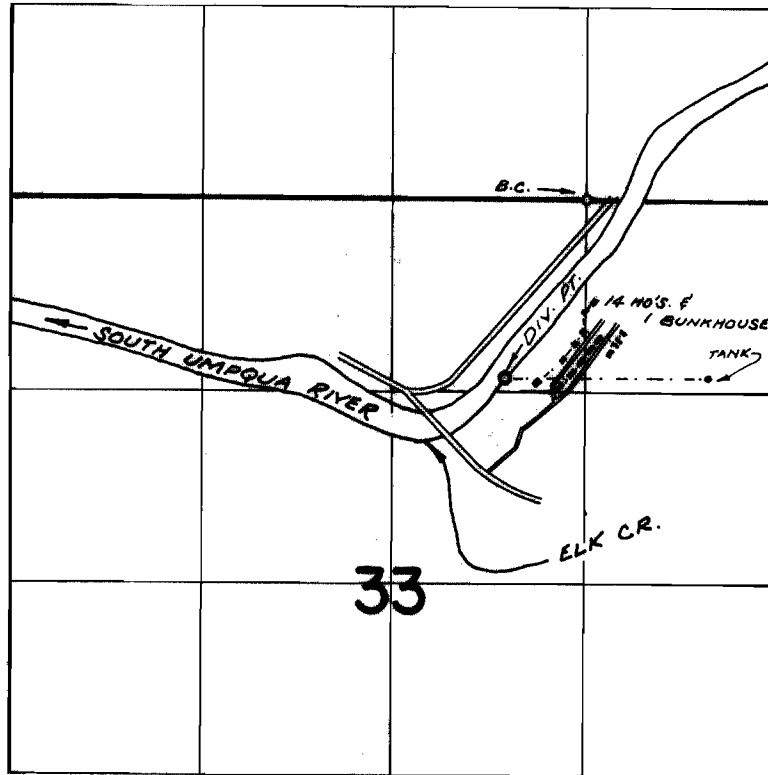

DIV. PT. LOC. 1230'S. & 570'W. FROM NE COR. NW $\frac{1}{4}$ NE $\frac{1}{4}$ SEC. 33

FINAL PROOF SURVEY
UNDER

Application No. 43788 Permit No. 32552
IN NAME OF

U.S.D.A. - FOREST SERVICE

Surveyed JUNE 13, 1973, by R. MUCKEN