


T. 23 S. R. 4 W. W.M.

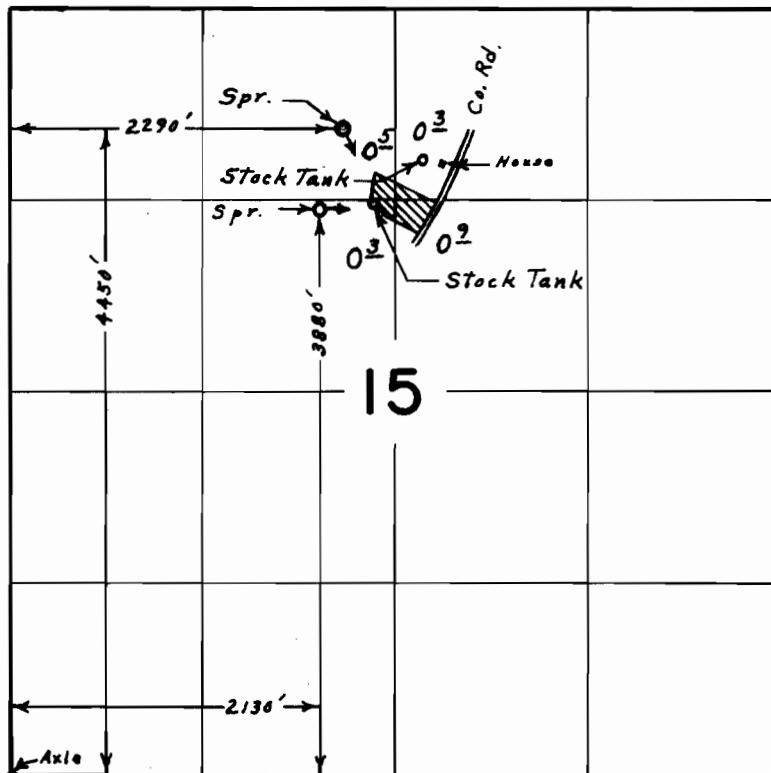

**FINAL PROOF SURVEY**  
UNDER

Application No. 44350 Permit No. 33240  
IN NAME OF

MARIAN F. BOWMAN THIES

Surveyed April 6, 1973, by L. E. Gould