


T 29 & 30 S R 5 W WM

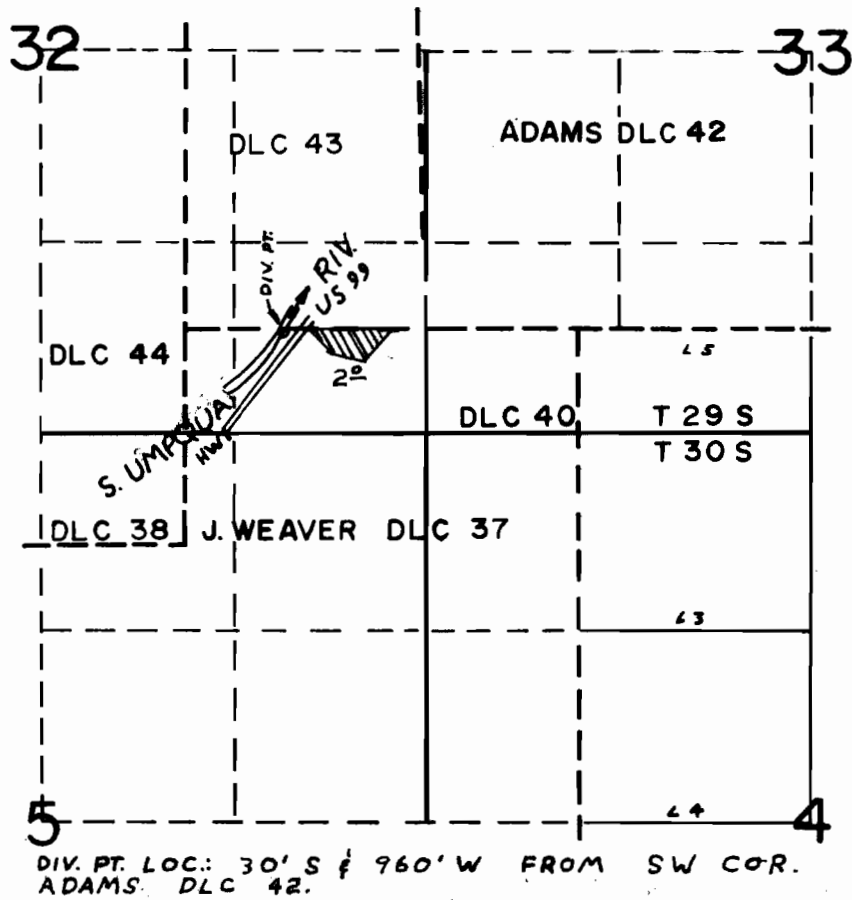

**FINAL PROOF SURVEY**  
UNDER

Application No. 46757. Permit No. 34942.  
IN NAME OF

*WILLIAM and AGNES OKELL*

Surveyed July 12 1974, by *L. H. NUNN*.