


T.26S. R.6W., W.M.

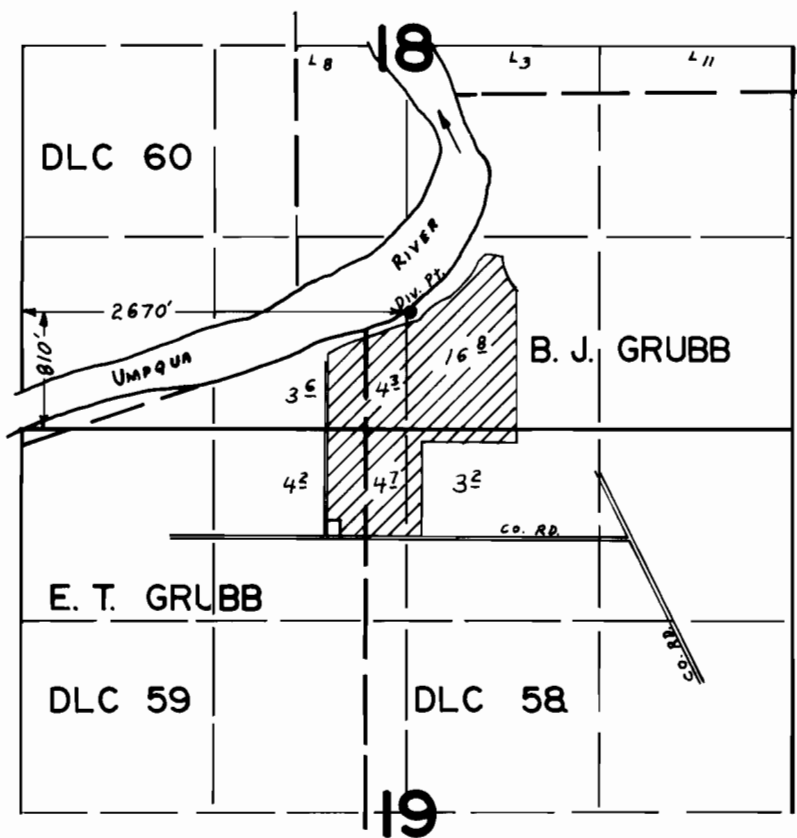

FINAL PROOF SURVEY UNDER

Application No. 49624... Permit No. 36562.....
IN NAME OF

.....MRS. HARRY (LOIS) WESLEY.....

Surveyed SEP. 11, 1973, by D. NORBY.....