


# T.39S.R.2W.W.M.

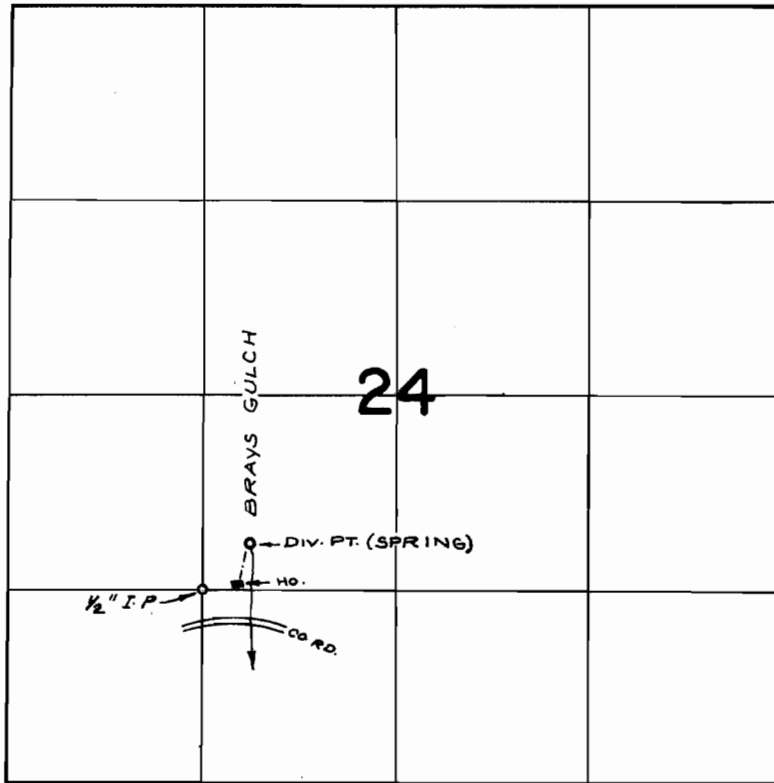

DIV. PT. LOC: 320' N. & 320' E. FROM SW. COR. NE  $\frac{1}{4}$  SW  $\frac{1}{4}$   
SEC. 24

## FINAL PROOF SURVEY UNDER

Application No. 38909 Permit No. 28962  
IN NAME OF

.....PAUL D. BRAY.....

Surveyed SEPT. 27, 1974, by R. MUCKEN