


T. 36 S. R. 4 W. W.M.

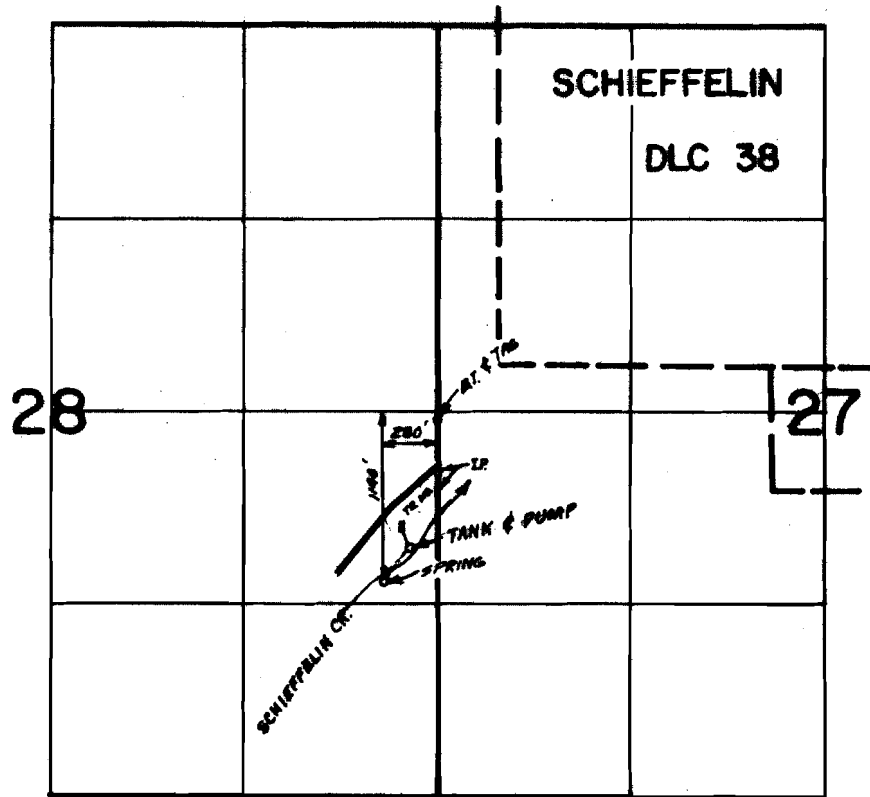

FINAL PROOF SURVEY
UNDER

Application No. 49679 Permit No. 37124
IN NAME OF

BRUCE H. & MYRLE B. WALKER

Surveyed OCT. 13, 1973, by R.G. MUCKEN