


T.37S.,R.5W.,W.M.

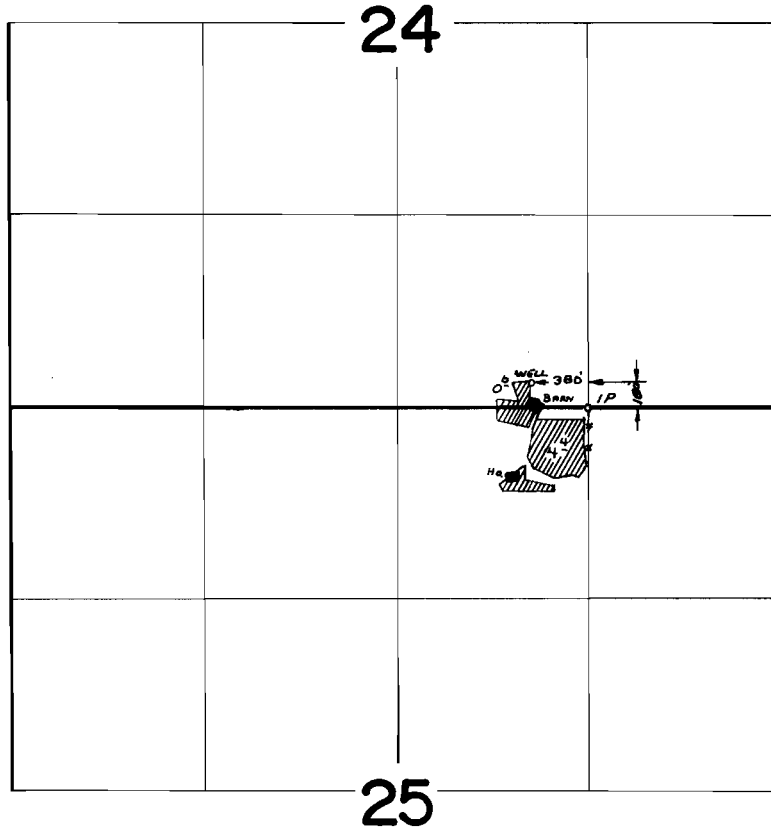

FINAL PROOF SURVEY
UNDER

Application No. G-4695 Permit No. G-4414
IN NAME OF

WILLIAM FINDLEY

Surveyed Oct. 7 1974, by L. T. Tolh