


T.37S.,R.9W.,W.M.

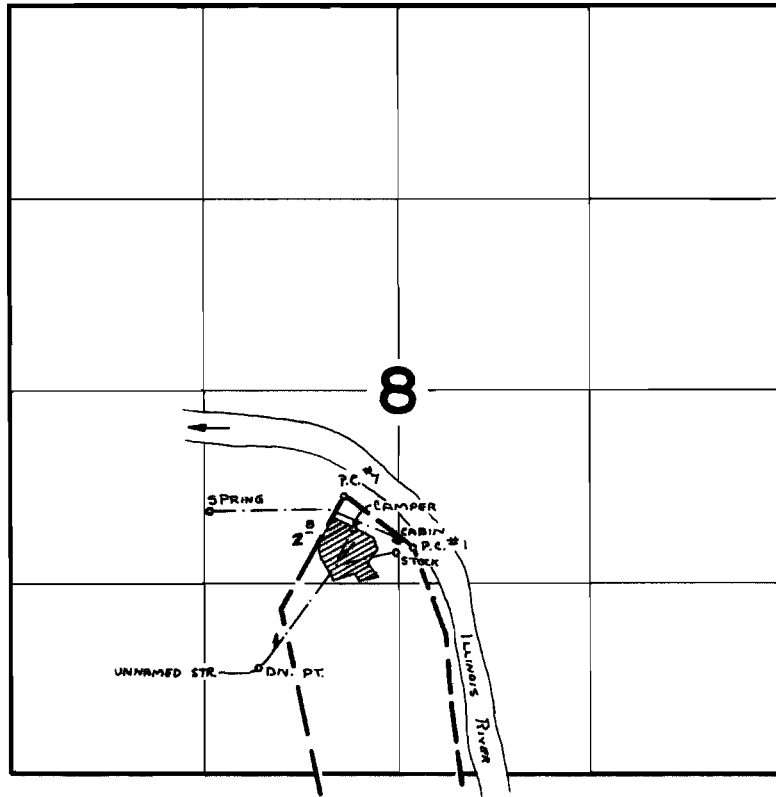

SPRING (A-45216) - 100' S AND 900' W FROM PROX COR. #17

*See A-45216
for location*

STREAM (A-52266) - 580' W. AND 1180' S. FROM PROX. COR. #17

FINAL PROOF SURVEY UNDER

Application No. **52266** / **45216** Permit No. **33776**
IN NAME OF

.....DOLORIS.....LLOYD.....

Surveyed SEPT. 10. 1974, by L. Toll