


# T.39S., R.8E., W.M.

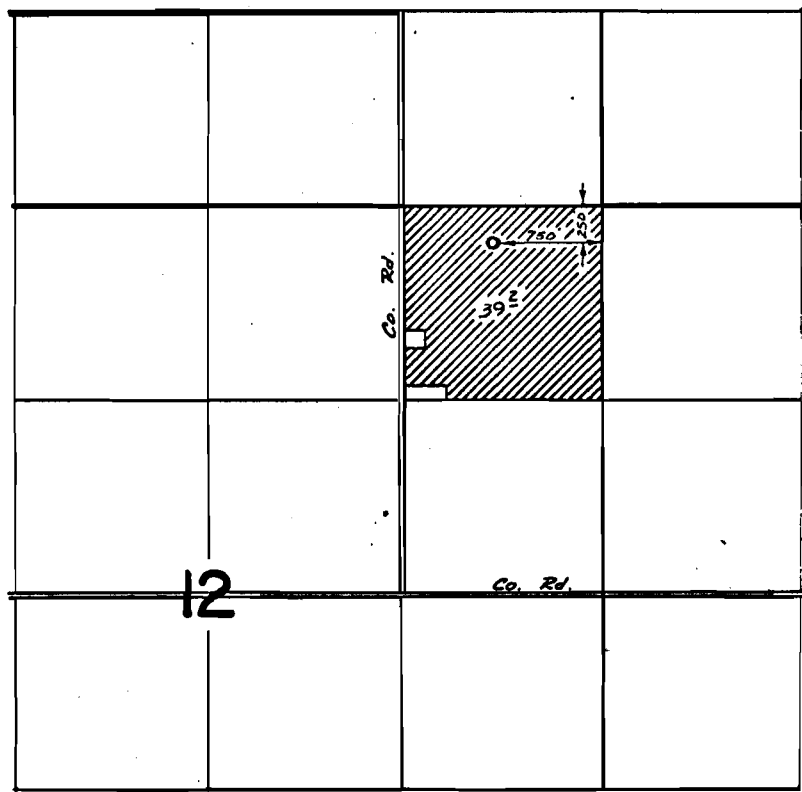

Klamath River wells

## FINAL PROOF SURVEY UNDER

Application No. G-3812 Permit No. G-3597  
IN NAME OF

Paul L. and Nancy L. Neal

Surveyed Oct. 18 1972, by D. Norby