


T.16S.R.4&5W.W.M.

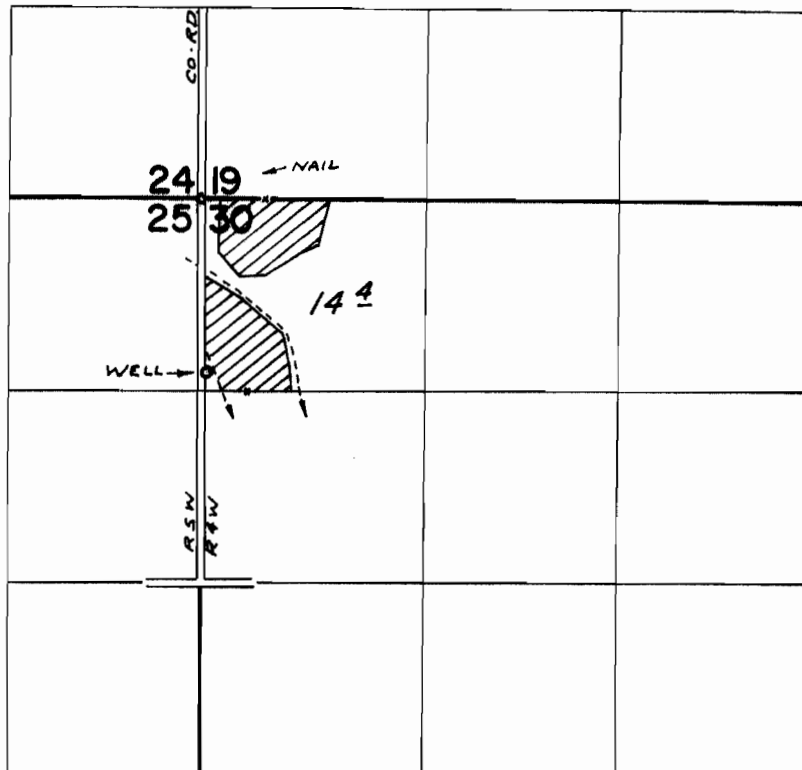

WELL LOC: 1190'S. & 30'E. FROM N.W. COR. SEC. 30

FINAL PROOF SURVEY
UNDER

Application No. G-5021 Permit No. G-4697
IN NAME OF

WILLIAM J. MERCHANT JR.

Surveyed OCT. 4 1973, by R. MUCKEN