


T.15S.R.4W.W.M.

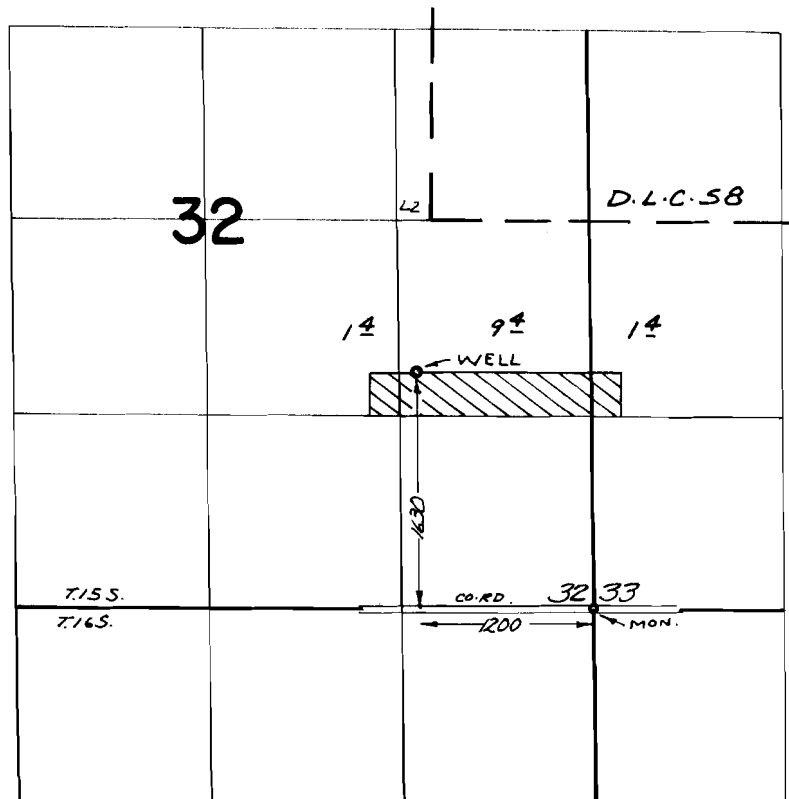

FINAL PROOF SURVEY
UNDER

Application No. G-5050 Permit No. G-4760
IN NAME OF

HERMAN & MARGIE DAILY

Surveyed SEPT. 28 1973, by R. MUCKEN