


T.15S., R. 5 W., W.M.

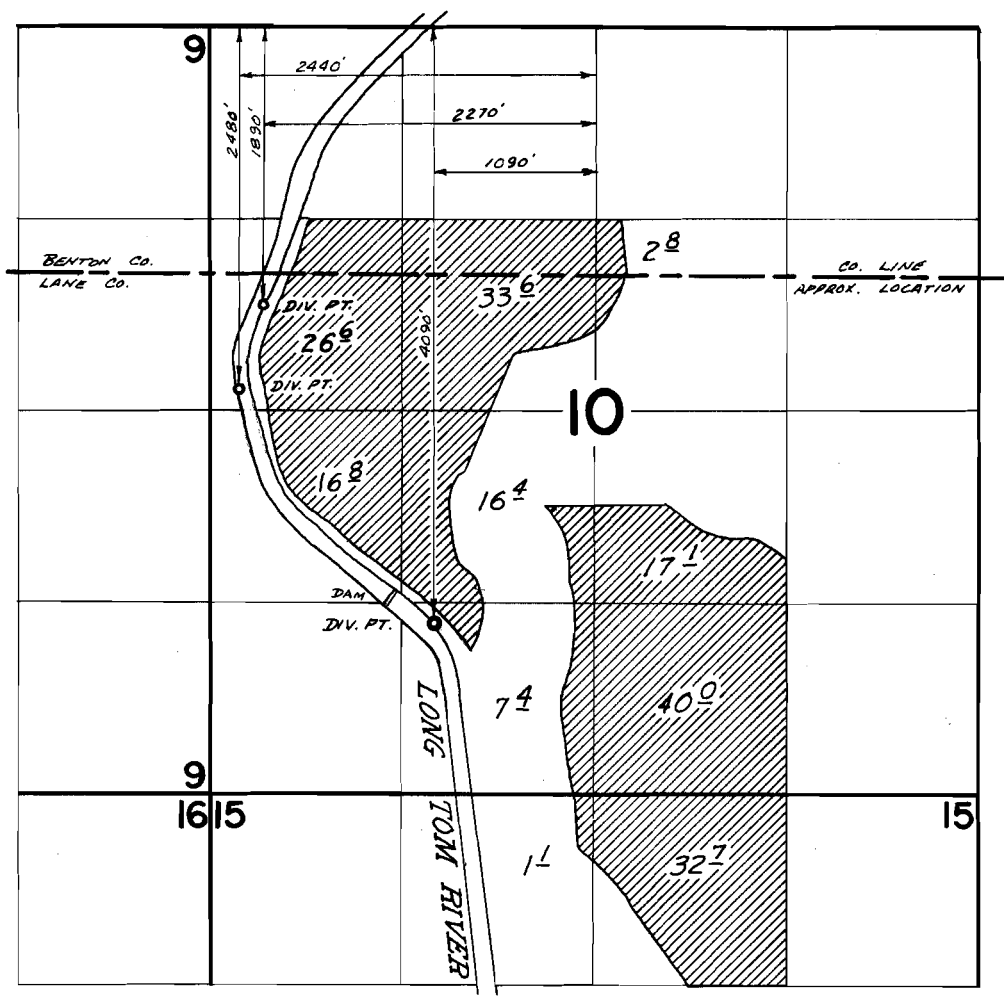

FINAL PROOF SURVEY
UNDER

44631 33500

Application No. 42478 Permit No. 31768
IN NAME OF

ROBERT STRODA

Surveyed August 25 1970, by L. E. GOULD