



T.15S., R.5W., W.M.

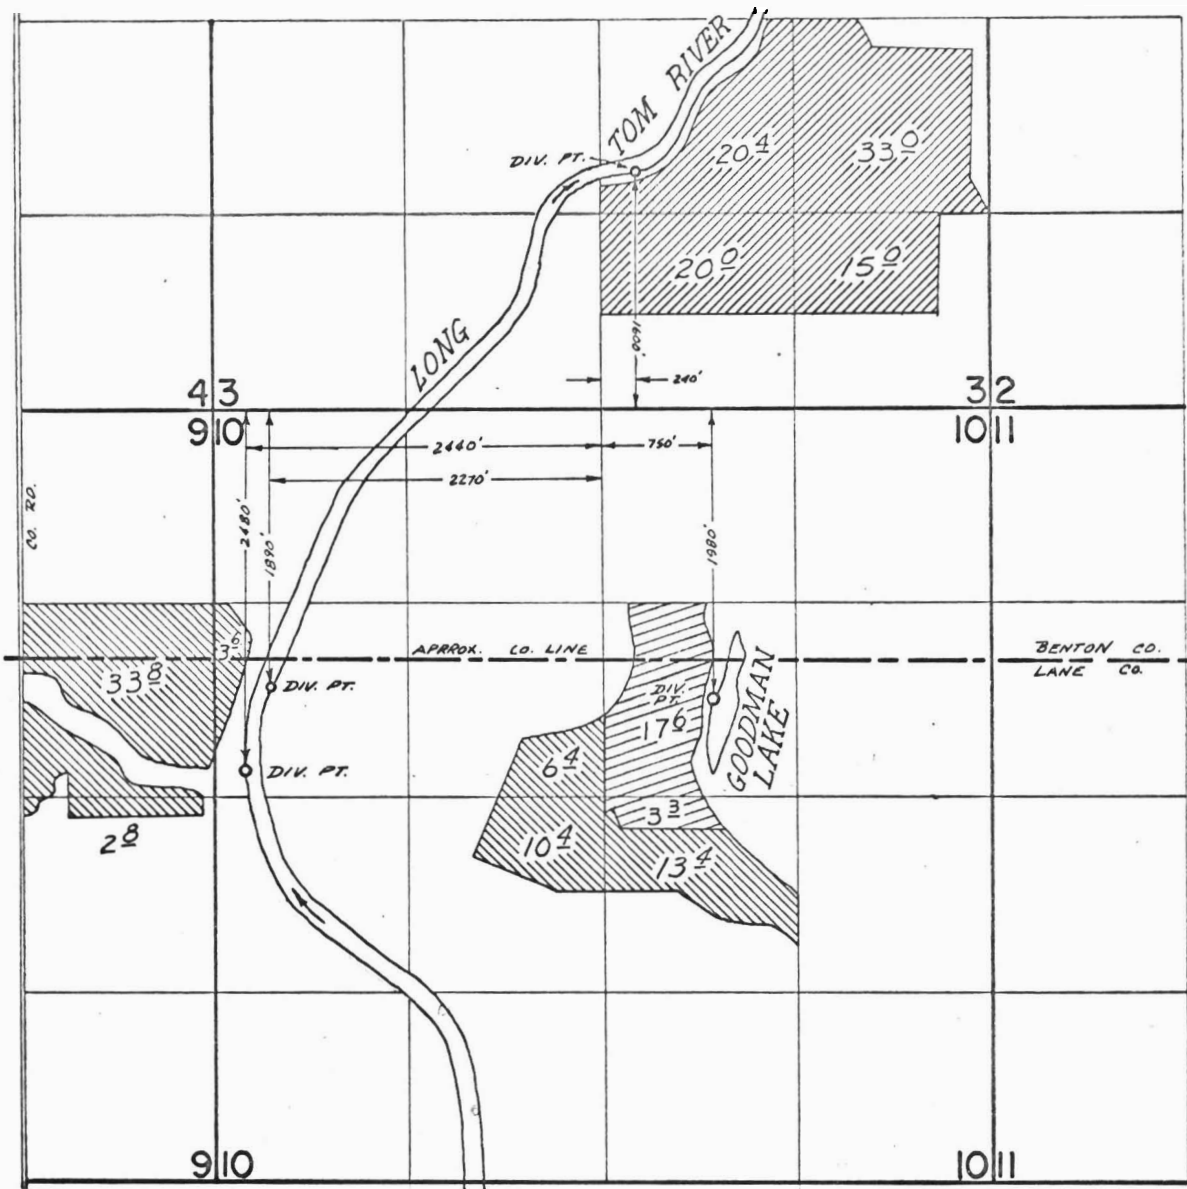

FINAL PROOF SURVEY
UNDER

Application No. 44364 33496
45521 33535
Permit No. 44363 33495
IN NAME OF

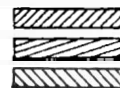

ROBERT STRODA

Surveyed Sept. 19 1973, by D. M. Noeby