


T.13S. R.10W. W.M.

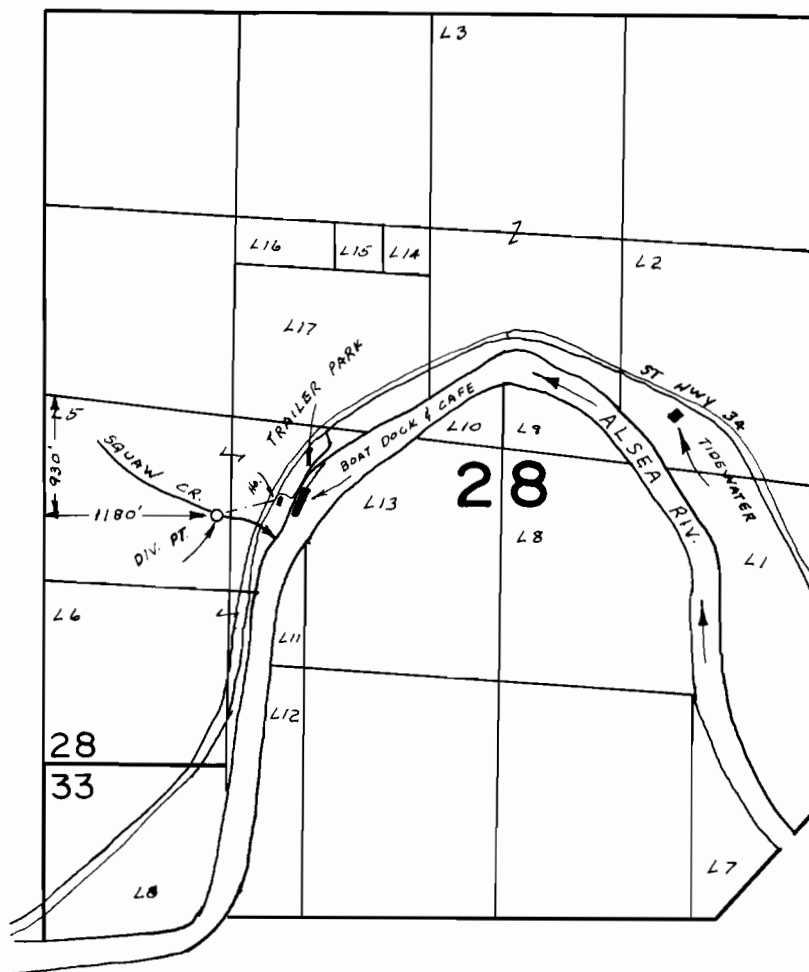

FINAL PROOF SURVEY UNDER

Application No. 46981... Permit No. 35151...
IN NAME OF

BYRON and CHARLOTTE FOWELL

Surveyed JUN. 5 1975, by L.H. NUNN