


# T.11S., R.2W., W.M.

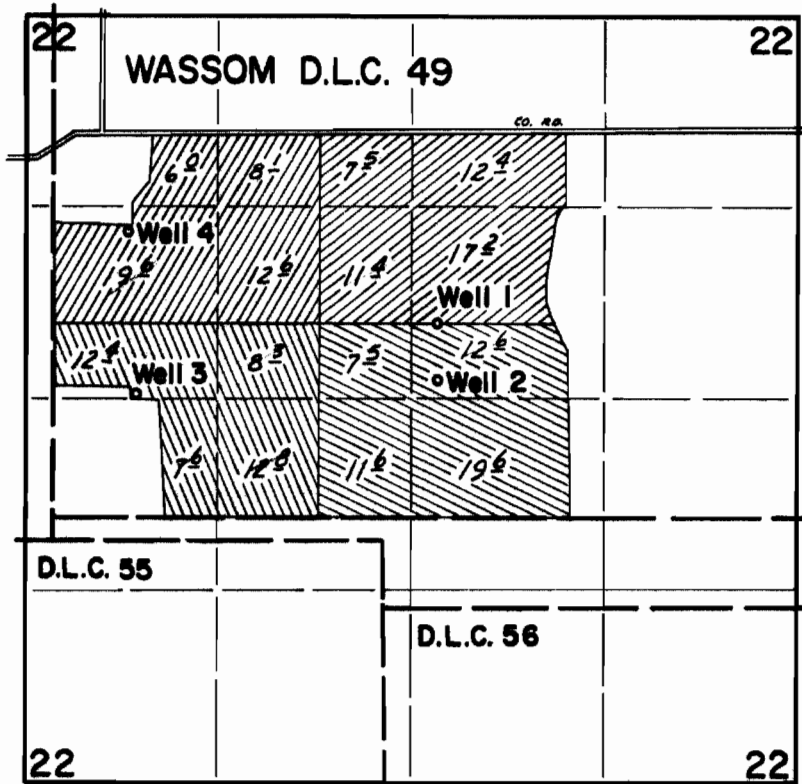

WELLS LOCATED: #1- 1340' N & 2640' E; #2- 950' N & 2640' E; #3- 850' N & 570' E; #4- 1960' N & 520' E; ALL FROM SW COR WASSOM DLC 49.



Well 1  
Well 2  
Well 3  
Well 4

## FINAL PROOF SURVEY UNDER

Application No. G-5034 Permit No. G-4744  
IN NAME OF

AMOS AND RUTH SCHMUCKER

Surveyed June 19, 1973, by D. Norby