


T.10S., R.2W., W.M.

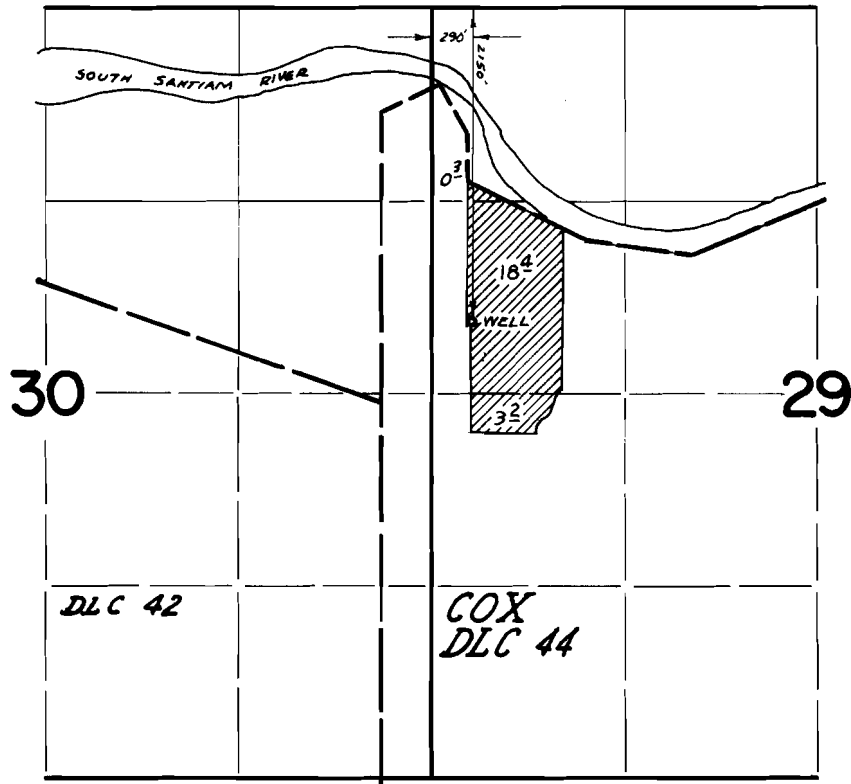

FINAL PROOF SURVEY
UNDER

Application No. G-5189 Permit No. G-5059
IN NAME OF

IVAN D. & LOLA M. ROTH

Surveyed June 22 1973, by D. Noeby