T. 18 S. R. 47 E. W.M.

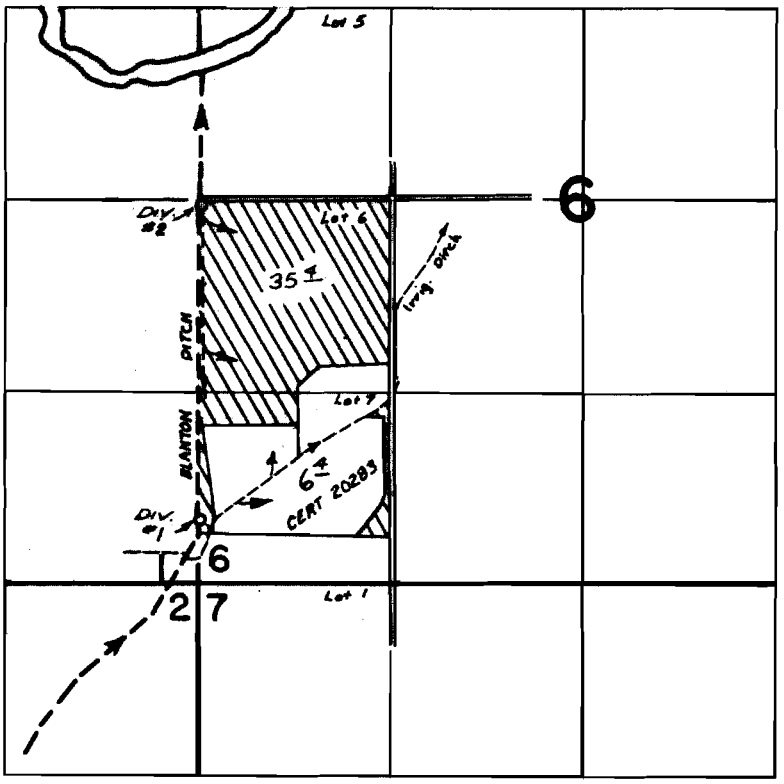

Pump #1 2200' S & 10' E, Pump #2 30' S & 10' E From W 1/4 cor Sec 6

FINAL PROOF SURVEY
UNDER

Application No. 42135 Permit No. 31511

IN NAME OF

DARRELL COCHRAN & MATH C. SCHIEMER

Surveyed AUG 28 1973, by L.E. GOULD

BBC-IN-84 DC