


# T.10S. R. 2W. W.M.

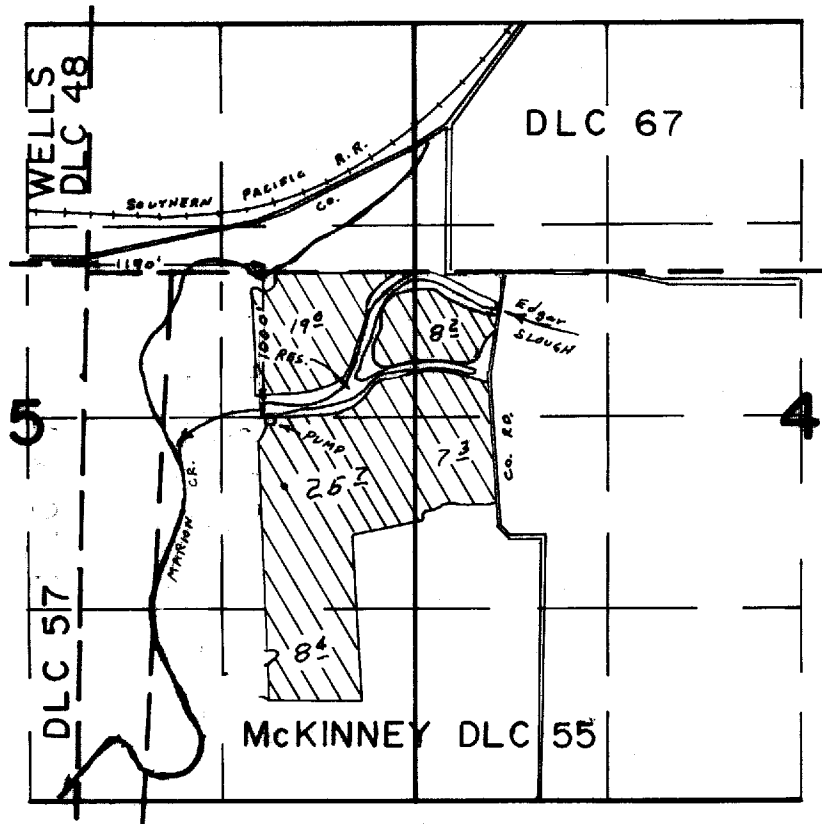

## FINAL PROOF SURVEY UNDER

R-46869                      R-5553  
Application No. 46870 Permit No. 34785  
IN NAME OF

Mc GILL BROS.

Surveyed SEP 6 1974, by L.H. NUNN