T. 3 N., R. 26 E., W.M.

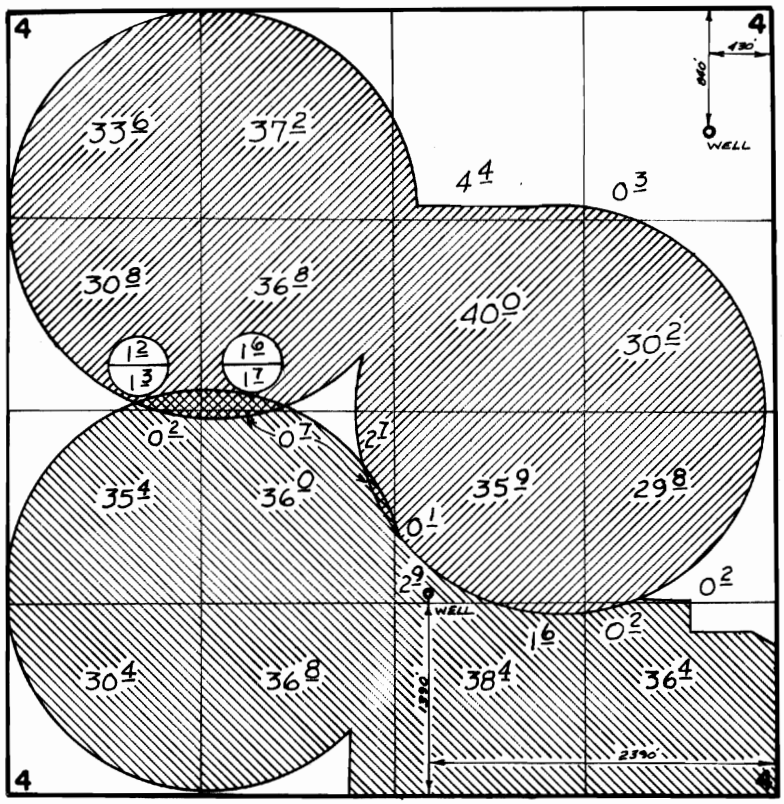

PRIMARY FROM NORTH WELL

PRIMARY FROM SOUTH WELL

PRIMARY FROM SOUTH WELL
SUPPLEMENTAL FROM NORTH WELL

NORTH WELL
SOUTH WELL

FINAL PROOF SURVEY

UNDER

Application No. G-1402 / G-1411 Permit No. G-1319 / G-1284

G-1319 South Well
G-1284 North Well

IN NAME OF

GEORGE S. BULOW

Surveyed April 18 1914, by David Norby

41049-272-121