





T. 3N., R. 26E., W.M.

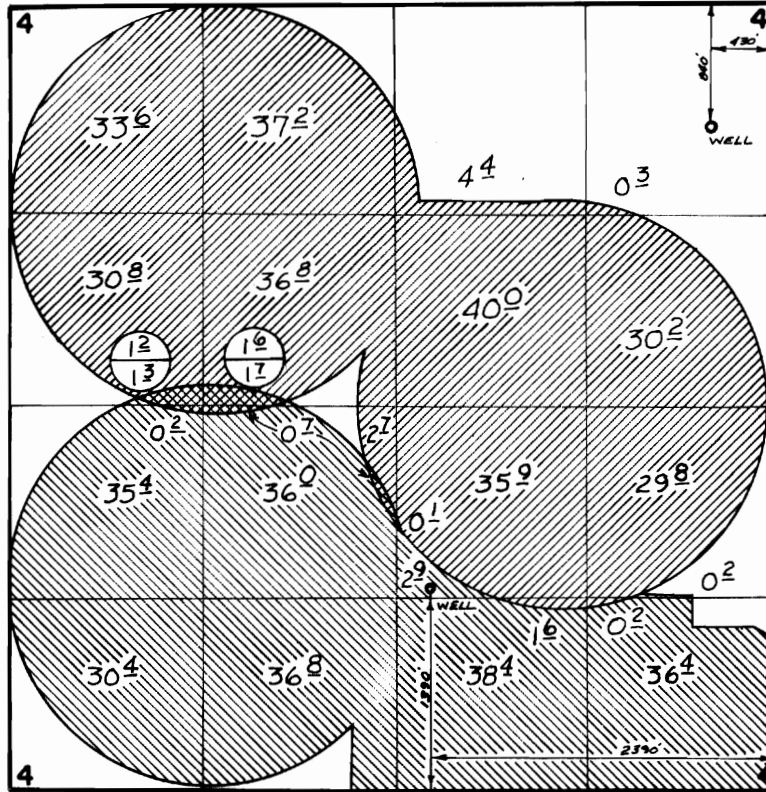

-  PRIMARY FROM NORTH WELL
-  PRIMARY FROM SOUTH WELL
-  PRIMARY FROM SOUTH WELL
SUPPLEMENTAL FROM NORTH WELL



FINAL PROOF SURVEY UNDER

Application No. G-1402 Permit No. G-1319 South Well
G-1411 G-1284 North Well
 IN NAME OF

GEORGE S. BULOW

Surveyed April 18 1914, by David Norby