


T.8S. R.7W. W.M.

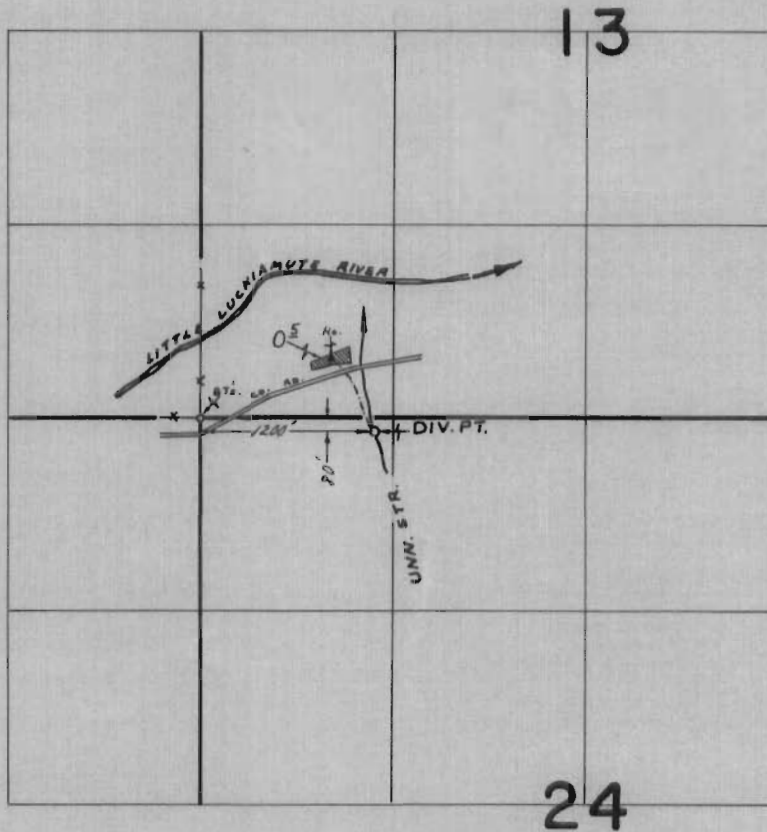

FINAL PROOF SURVEY
UNDER

Application No. 47736 Permit No. 35758
IN NAME OF

E. D. and MARIE S. BOBO

Surveyed MARCH 30, 1973, by R. MUCKEN