


T.8S. R.6W. W.M.

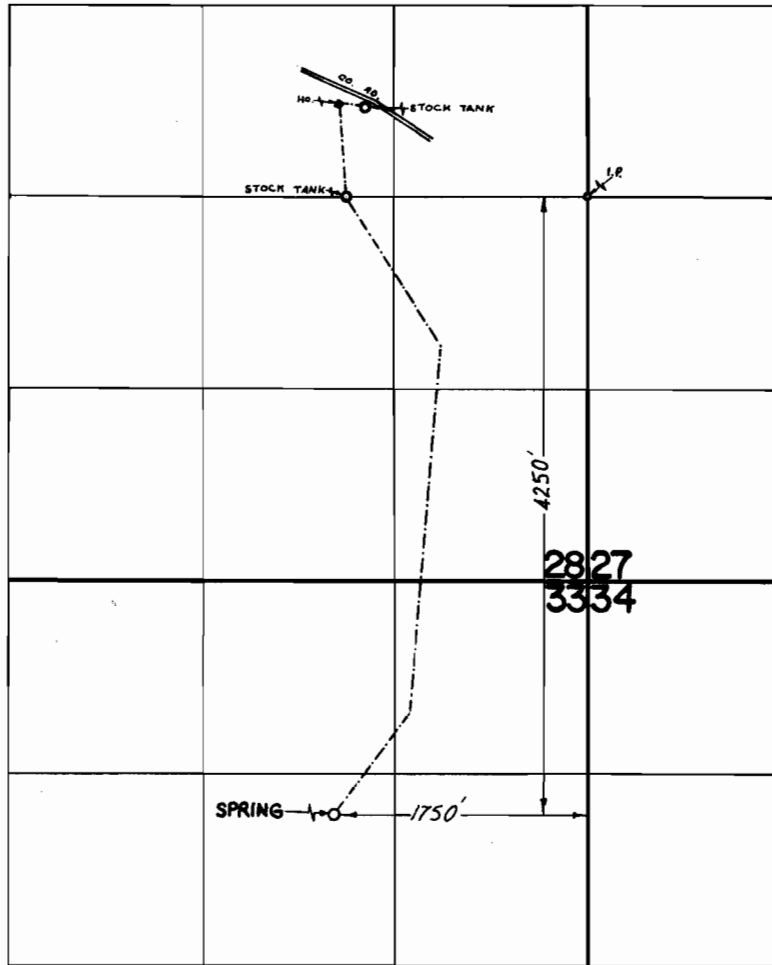

**FINAL PROOF SURVEY**  
UNDER

Application No. 48606 Permit No. 35965  
IN NAME OF

**JOHN DORAN**

Surveyed APRIL 2, 1973, by R. MUCKEN