


T.9S. R.4W. W.M.

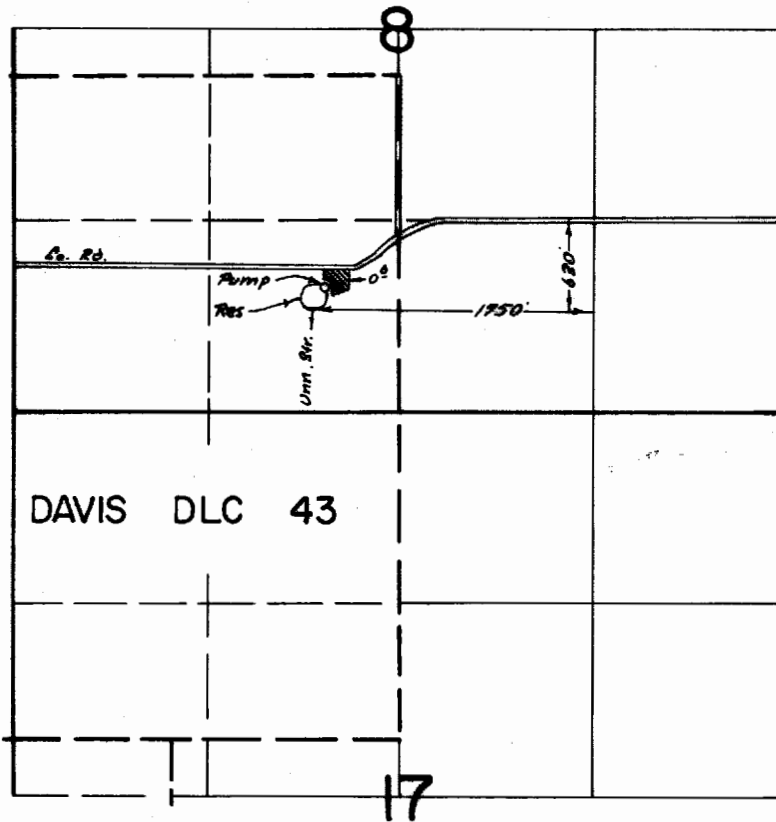

FINAL PROOF SURVEY
UNDER

Application No. R-43177 4317B Permit No. R-4946 32280
IN NAME OF

DONALD LUNDEEN

Surveyed March 20 1979, by R.G. Mucken