


T.6S. R.5W. W.M.

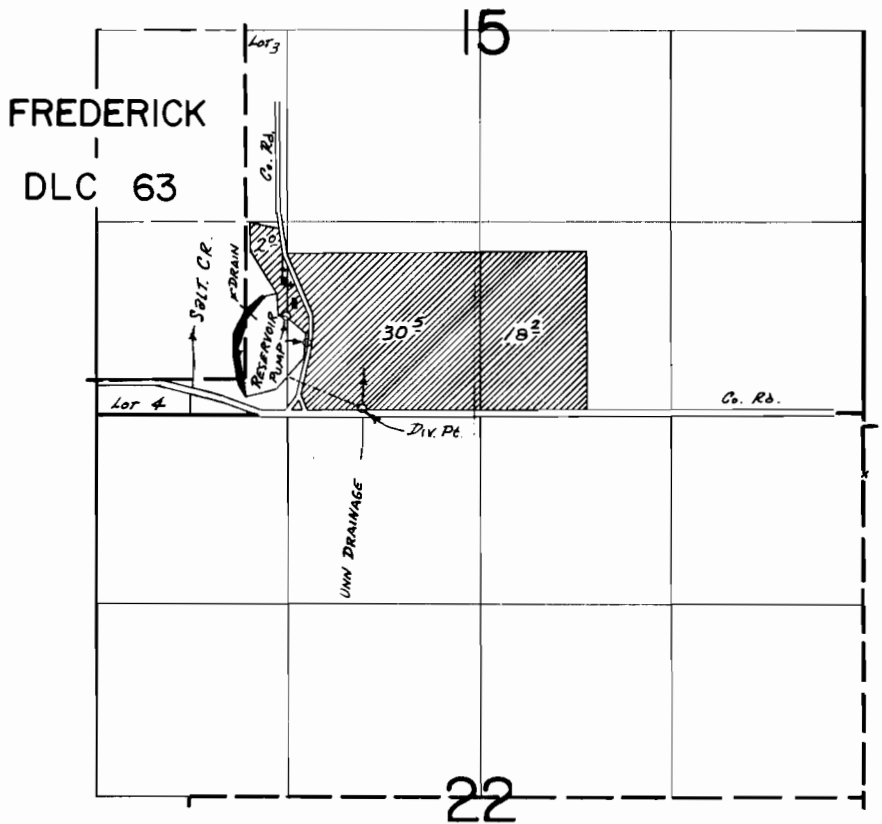

RES. Loc. 680' N & 1590' W ; Div. Pt. Loc. 30' N & 810' W FROM S 1/4 COR SEC 15'

FINAL PROOF SURVEY

UNDER

R-45056 R-5319
Application No. 45057 Permit No. 33671
IN NAME OF

BOB SCHARF

Surveyed April 25 1974, by T. J. PAUL