


T.6S. R.5W. W.M.

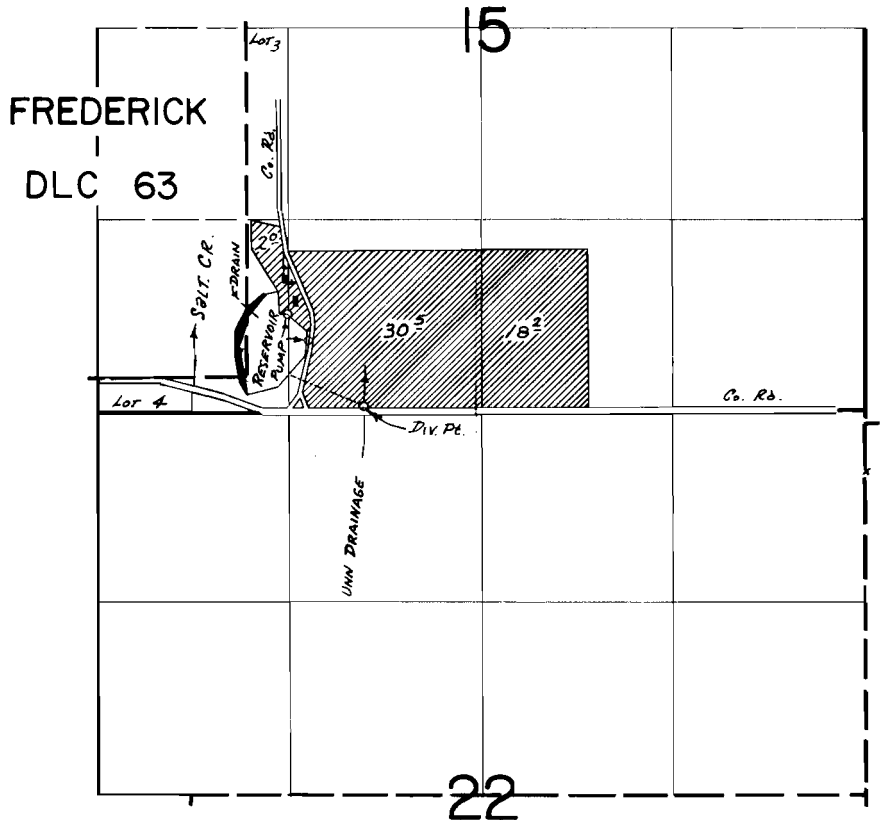

RES. Loc. 680' N & 1590' W; DIV. Pt. Loc. 30° A & 810' W FROM S 1/4 COR SEC 15'

FINAL PROOF SURVEY
UNDER

R-45056 R-5319
Application No.45057 Permit No.33671.
IN NAME OF

.....BOB SCHARF.....

Surveyed April 25 1974, by T. J. PAUL.....