


T.6S. R.5W. W.M.

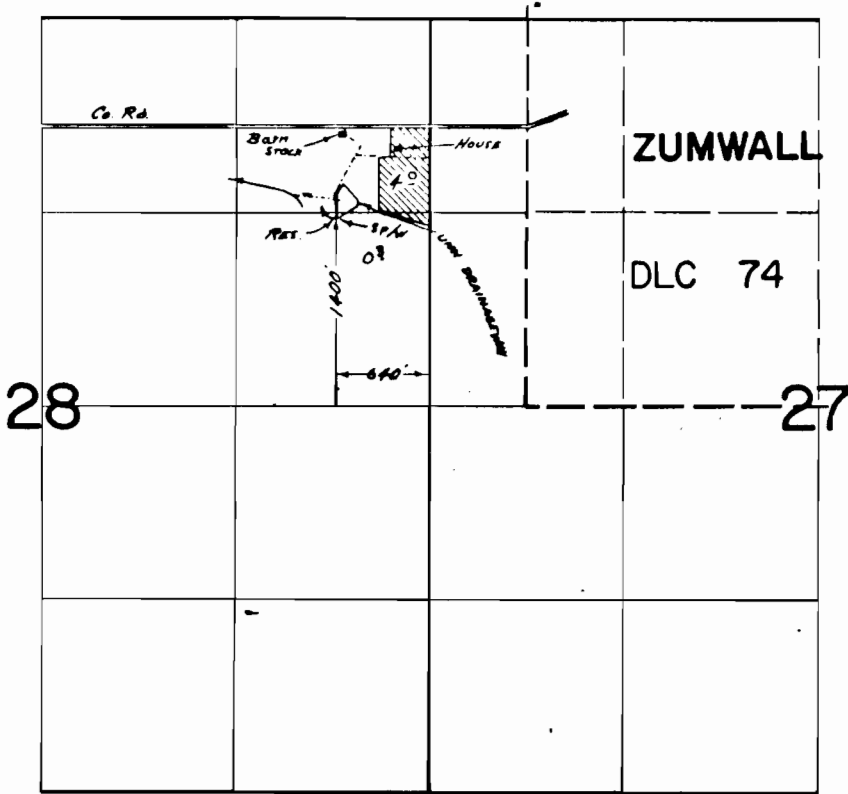

FINAL PROOF SURVEY
UNDER

R-46207 R-5497
Application No.46208 Permit No.34524
IN NAME OF

.....DALE SWEARINGEN.....

Surveyed April 23, 1974, by T. J. PAUL.....