


T.9S. R.6W. W.M.

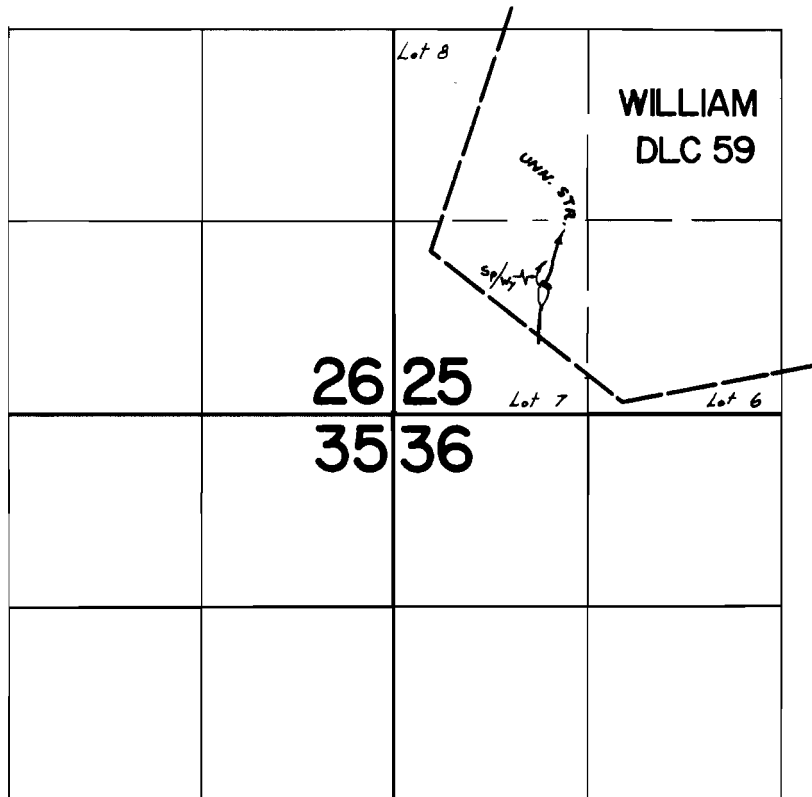

FINAL PROOF SURVEY
UNDER

Application No. R-47260 Permit No. R-5681
IN NAME OF

PAUL A. & DORIS M. WILSON

Surveyed MARCH 27, 1973, by R. MUCKEN