


T.6S. R.6W. W.M.

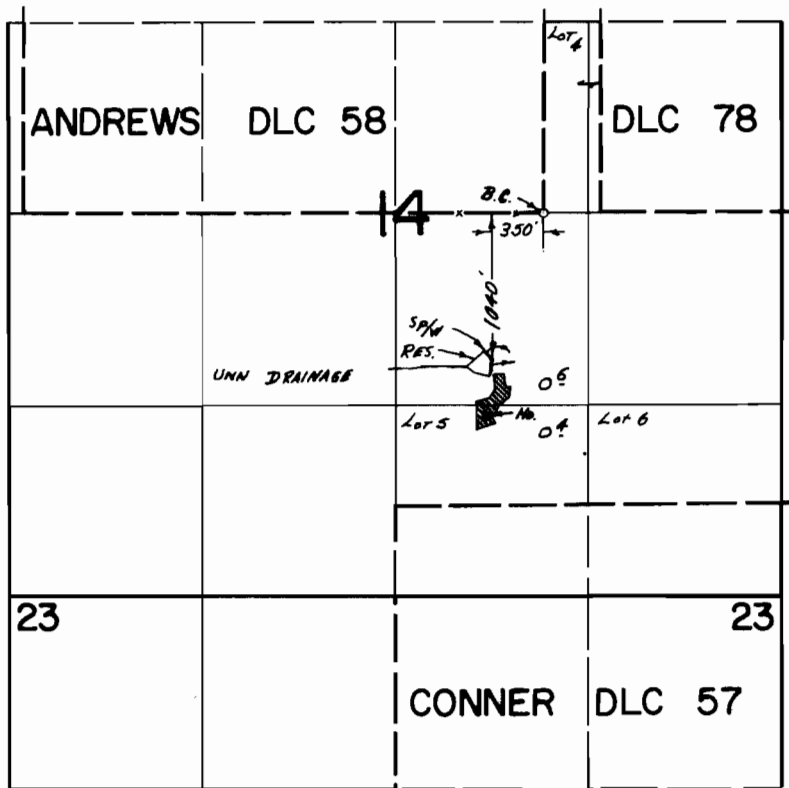

FINAL PROOF SURVEY UNDER

R-47298 R-5698
 Application No. 47299 Permit No. 35440
 IN NAME OF

RICHARD NIMROD

Surveyed June 20 1974, by T. J. PAUL