


# T.6S. R.6W. W.M.

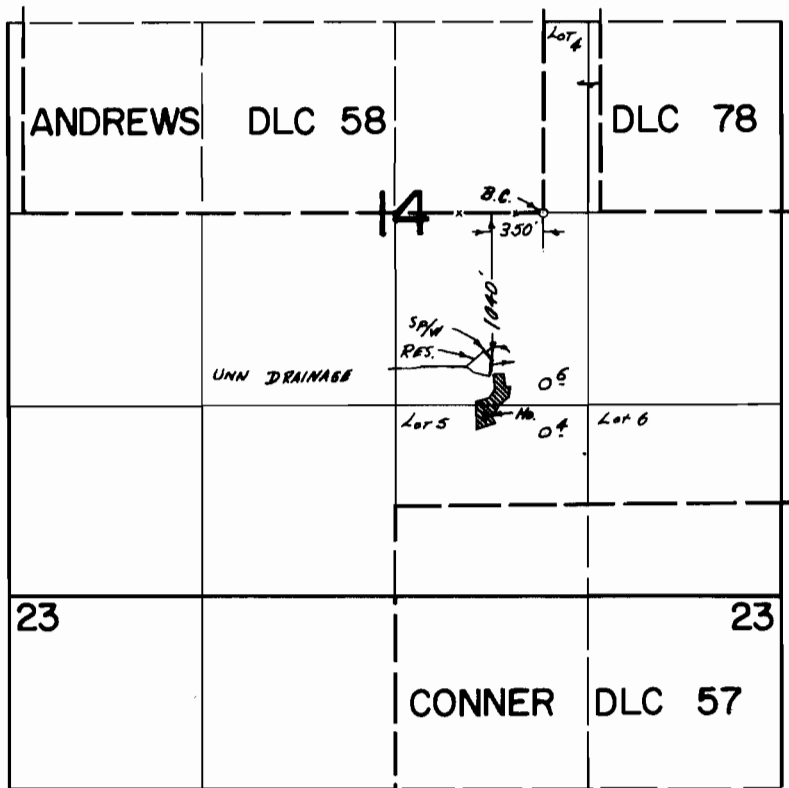

## FINAL PROOF SURVEY UNDER

R-47298                      R-5698  
Application No. 47299 Permit No. 35440  
IN NAME OF

RICHARD NIMROD

Surveyed June 20 1974, by T. J. PAUL