


T.9S. R.6W. W.M.

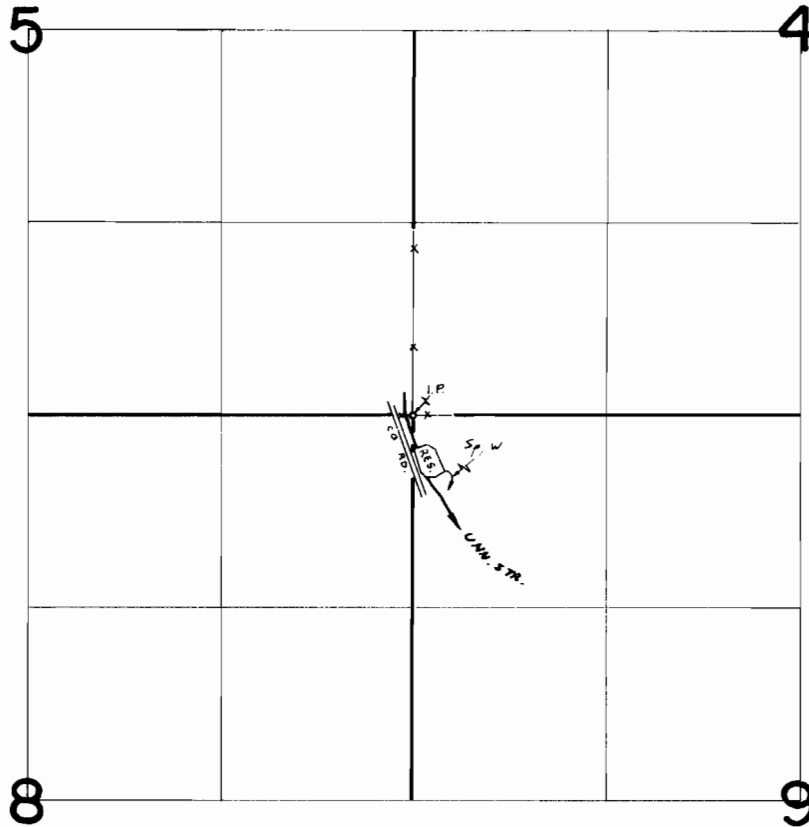

FINAL PROOF SURVEY
UNDER

Application No. R-47547 Permit No. R-5726
IN NAME OF

ROBERT JAHN

Surveyed MARCH 28 1973, by R. MUCKEN