


# T.6&7S. R.6W. W.M.

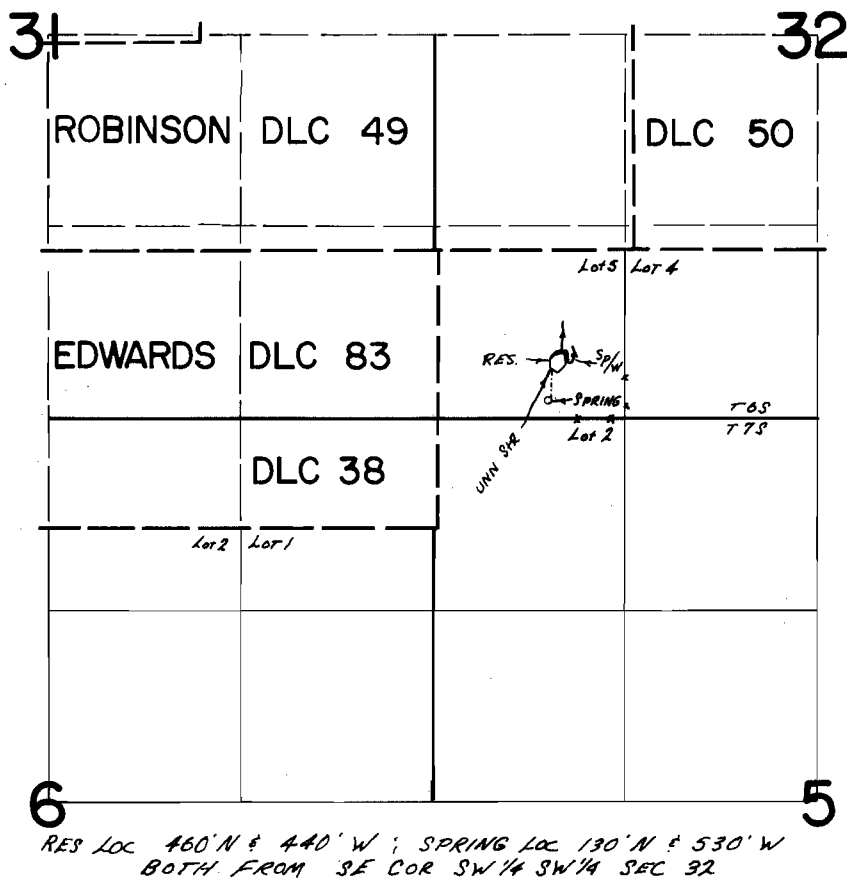

## FINAL PROOF SURVEY UNDER

R-49436                      R-6014  
Application No. 49437 Permit No. 37104  
IN NAME OF

CHARLES WILHELM

Surveyed April 22 1974, by T. J. PAUL