


T.6&7S. R.6W. W.M.

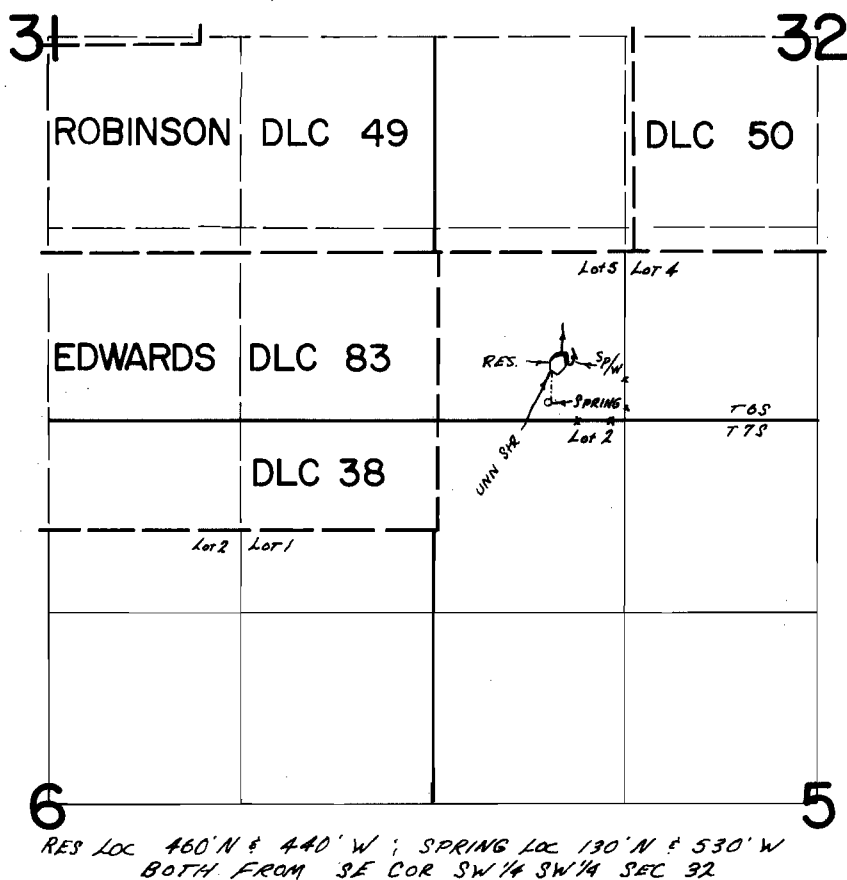

FINAL PROOF SURVEY UNDER

R-49436 R-6014
Application No. 49437 Permit No. 37104
IN NAME OF

CHARLES WILHELM

Surveyed April 22 1974, by T. J. PAUL