T.2S.,R.7&8W.,W.M.

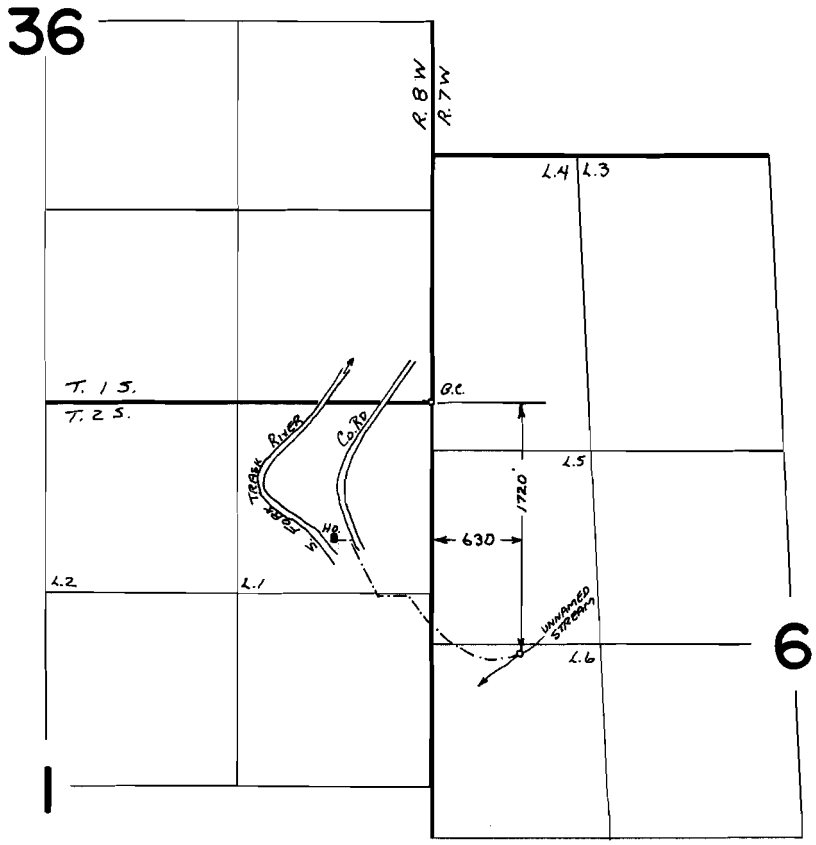

FINAL PROOF SURVEY
UNDER

Application No. 39915 Permit No. 29777
IN NAME OF

ELMER J. SCHWEIZER

Surveyed JUNE 24 1974, by L. TOLL

PTS 1974-V