


T. 4 S., R. 10 W., W.M.

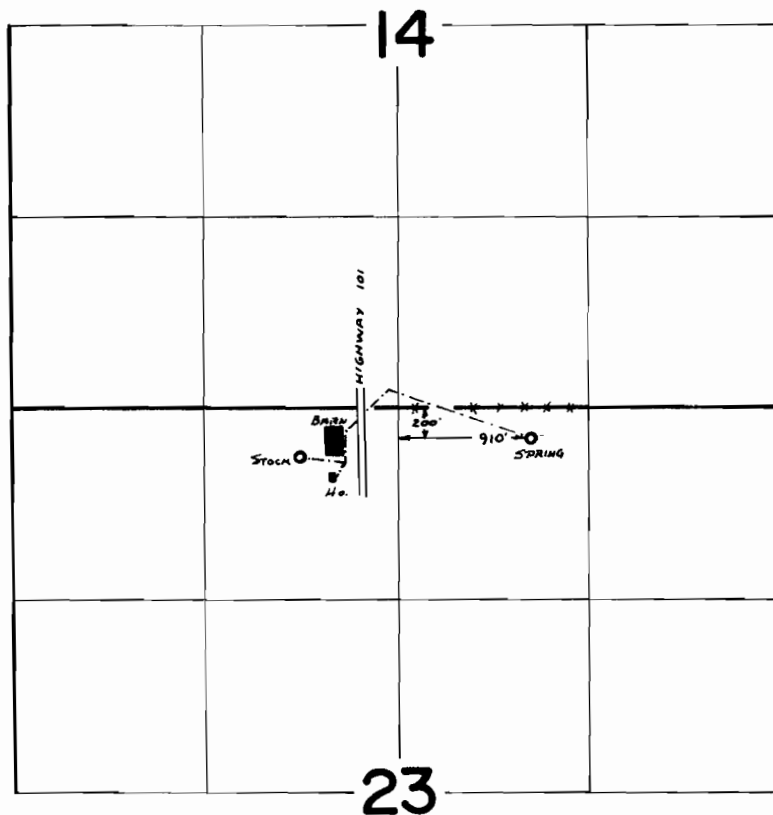

FINAL PROOF SURVEY
UNDER

Application No. 49156 Permit No. 36095
IN NAME OF

Estate of C.J. Ramsland and A. Maxine Ramsland

Surveyed JUNE 26 1974, by L. TOLL