


Scale: 4" = 1 Mile

Date: Dec. 21, 1959

I, STANLEY G. WALLULIS, of PENDLETON, OREGON DO HEREBY CERTIFY THAT THIS MAP WAS MADE FROM NOTES TAKEN DURING AN ACTUAL SURVEY MADE BY ME ON DECEMBER 15, 1959; THAT THE MONUMENT SHOWN ON THIS MAP CONSISTING OF A 5/8" IRON PIN 30" LONG IS N 67°32'30" E AND 1,416.08 FEET FROM THE S.W. CORNER OF SECTION 27, TWN 2N, R32E

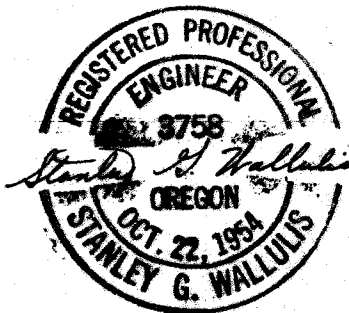

Stanley G. Wallulis

Application No. S-1652
 Permit No. S. 1518