


T.3S.R.38E. W.M.

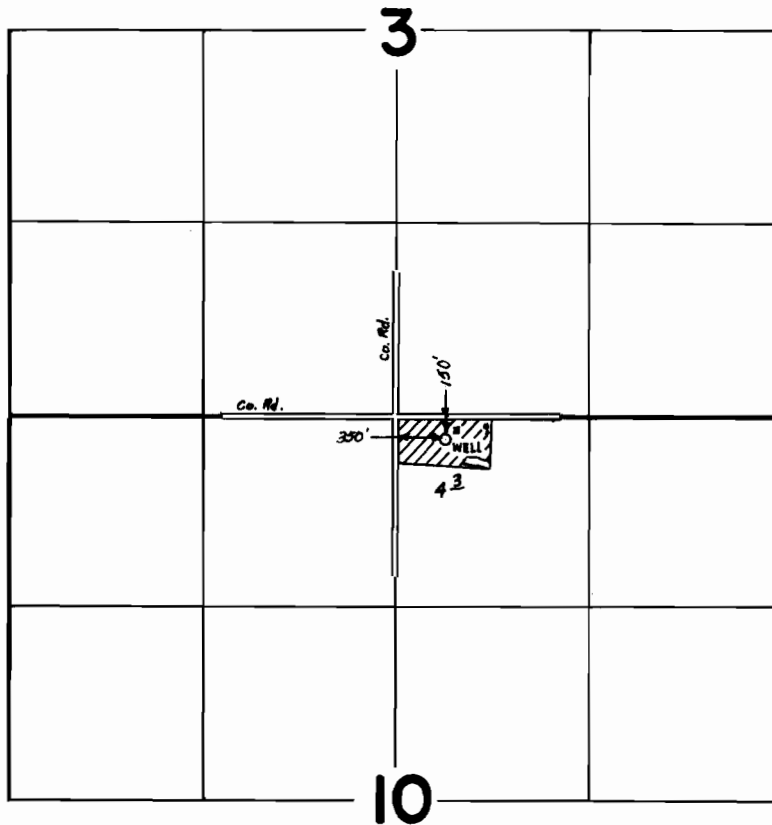

FINAL PROOF SURVEY UNDER

Application No. G-4056 Permit No. G-3828
IN NAME OF

DALE MATTSON

Surveyed JULY 10 1973, by DAVE NORBY