


T 1 N. & 1 S. R. 38 E. W. M.

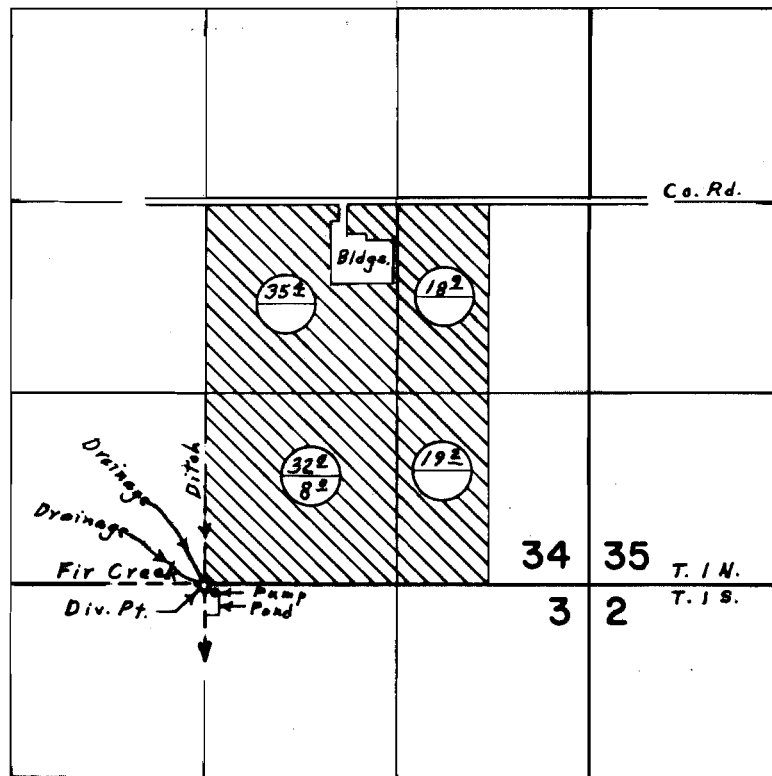

Well located 10' S. & 10' W. from N $\frac{1}{4}$ Cor. Sec. 3

Primary
Supplemental



FINAL PROOF SURVEY UNDER

Application No. 41836 Permit No. 31252
IN NAME OF

MIKE ROYES

Surveyed Aug. 2, 1973, by L. E. Gould