


T. 15. R. 44 E. W. M.

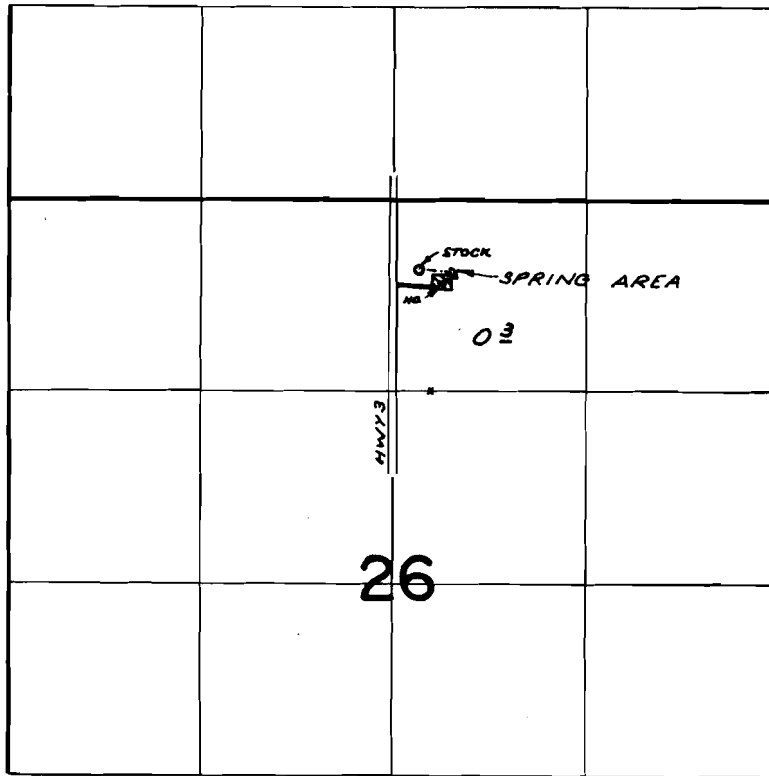

SPRING AREA LOC: 820' N. & 410' E. FROM S.W. COR.
NW 1/4 NE 1/4 SEC. 26

FINAL PROOF SURVEY UNDER

Application No. 11807..... Permit No. 31295.....
IN NAME OF

CLYDE L. & HELEN M. STONEBRINK

Surveyed AUG. 2, 1973, by R. MURKEN.