


T.1N. R.48E. W.M.

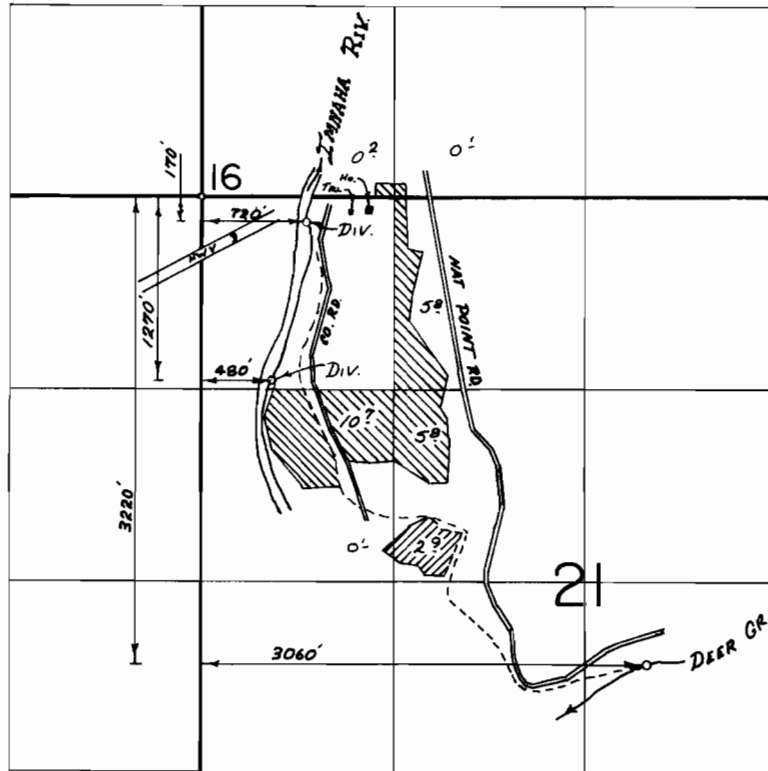

IMNANA RIVER  
DEER CREEK

**FINAL PROOF SURVEY**  
UNDER

TRANSFER No. 2339

Application No. 46550 Permit No. 34770

IN NAME OF

RAY & HARRY HARP

Surveyed AUG 4 1973, by R. G. MUCKEN