


T.I.N.R.4W.W.M.

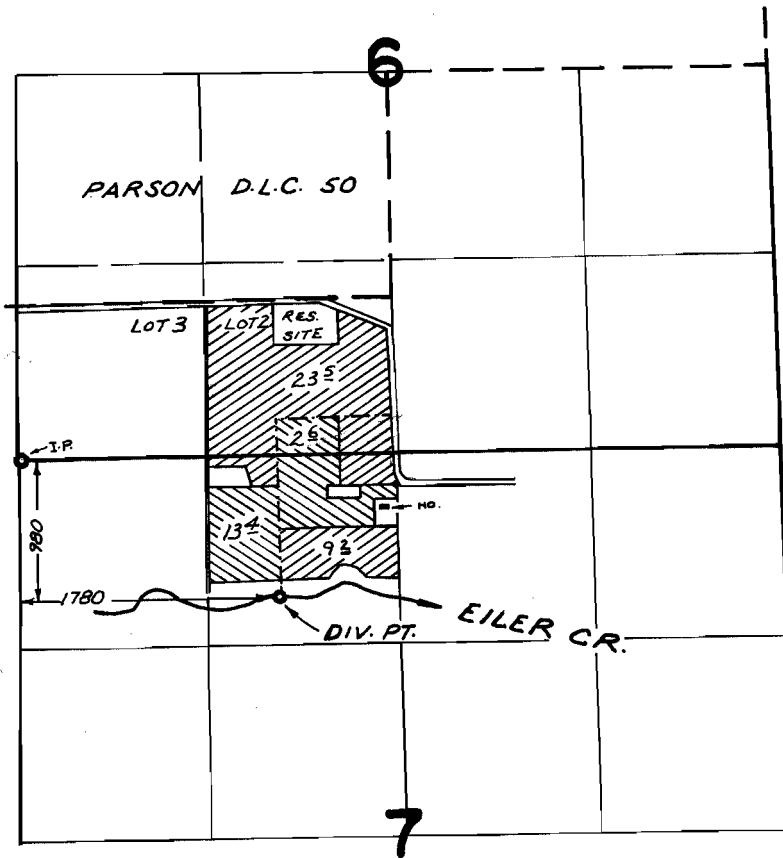

FINAL PROOF SURVEY

UNDER



TRANSFER NO. 2550

Application No. 48498 Permit No. 35835

IN NAME OF

ALBERT JESSE

Surveyed NOV. 7, 1974, by R. MUCKEN